IREDELL COUNTY HEALTH DEPARTMENT

STATESVILLE 704-878-5305 MOORESVILLE 704-664-5281

IMPROVEMENT PERMIT / CERTIFICATE OF COMPLETION / OPERATION PERMIT / EXISTING SYSTEM INSPECTION

PROPERTY DESCRIPTION NO. 18007 DATE 3/14/94 TAX MAP NO. 2N 1A 206 Watershed: ☐ Yes ☒ No

OWNER OR CONTRACTOR A R CAMPBELL JR. PHONE: Business Home 910-869-2323

ADDRESS 2400 EASTOVER PLACE HIGH POINT, NC. 27625 4638037409

LOCATION ROBINSON RD; 150' W TRON ROBINSON RD, .8 MILE ON (L)

SUBDIVISION CL+T BLOCK / SECTION 11 LOT 206 LOT AREA .7 AC. SITE CLASS. P. DESIGN FLOW 360 L.T.A.R.

Septic Tank: EXISTING Gallons; STB Date

Pump Tank: Gallons; PT Date

Pump Make: Model Serial No.

Nitrification Field: No Fields 1 Square Feet Linear Feet

No Lines Trench Width Existing Max Trench Bottom Depth Gravel Depth

☒ New System ☐ Repair System Type: I (II) III, IV, V, VI

System Description: Existing

Repair System Description:

Maintenance Agreement Required: ☐ Yes ☒ No

☐ House/Mod. Home ☒ Mobile Home-D/W ☐ Business ☐ Other

No. Bedrooms 3 No. Bathrooms 2 No. Employees

☐ Slab ☐ Crawl Space ☐ Basement w/plumbing ☐ Basement wo/plumbing


Water Supply: ☒ Individual ☐ Community ☐ Public

Comments:

Comments:

INITIAL SITE SKETCH

AS BUILT SKETCH

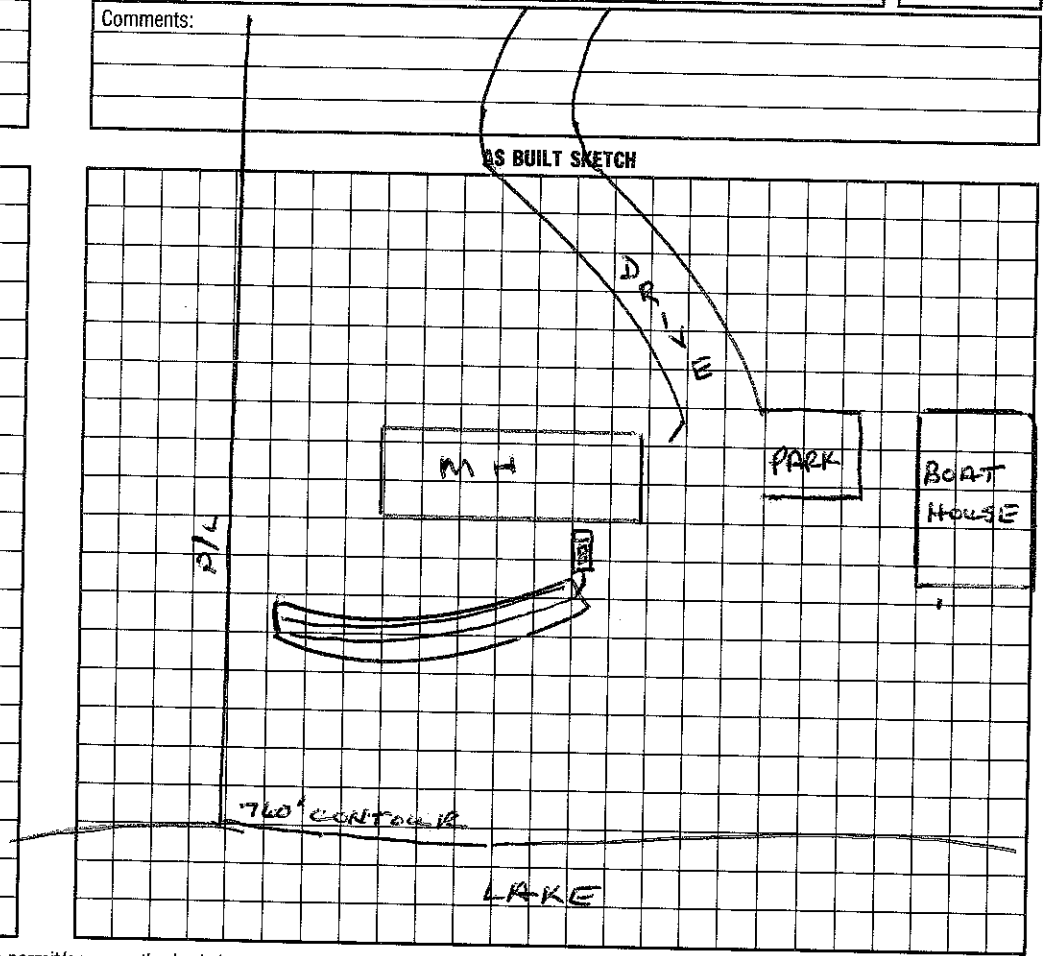

I understand that this permit can be suspended or revoked if any false information is supplied toward securing the permit/any unauthorized changes are made to the site/any unauthorized changes are made in the installation of the system. Improvement Permit is valid for 60 months from date of issuance.

Signed:

Improvement Permit by: date

Existing System Inspection by: Wesley Sparks R.S. date 3/14/94

Installed by:

Certificate of Completion by: date

Operation Permit by: date

HEALTH DEPT. COPY: WHITE INSPECTION COPY (FINAL): GREEN OWNER COPY (FINAL): YELLOW INSPECTION COPY (INITIAL): PINK OWNER COPY (INITIAL): GOLD