FS Erwin — (1100)

IREDELL COUNTY HEALTH DEPARTMENT

STATESVILLE 704-878-5305 MOORESVILLE 704-664-5281

IMPROVEMENT PERMIT / AUTHORIZATION TO CONSTRUCT / OPERATION PERMIT / EXISTING SYSTEM INSPECTION

PERMIT# 075866 PIN# 4638 045259 DATE Oct. 15, 98

OWNER OR CONTRACTOR Frank DeSimone PHONE: Business 788-6023 Home

ADDRESS 811 Robinson Rd. Concord, N.C. 28025

LOCATION 150W TR Robinson Rd. on Right

SUBDIVISION Robinson Woods BLOCK / SECTION LOT 6 LOT AREA .57AC SITE CLASS PS DESIGN FLOW 480gpd L.T.A.R. ~.3

Septic Tank: 1000 Gallons; STB 794 Date 12/20/98
Pump Tank: 1000 Gallons; PT 27 Date 2/12/99
Pump Make: Gavlas Model WE031M Serial No. M7846767
Nitrification Field: No Fields 1 Square Feet 1200 Linear Feet 400
No Lines 3@134' Trench Width 36" Max Trench Bottom Depth ~30" Gravel Depth NA

☑ New System ☐ Repair System Type: I, II, ☑ IV, V, VI
System Description: Pumped pm - 25% Reduction
Repair System Description: LP Panel Block
Maintenance Agreement Required: ☐ Yes ☑ No

☑ House/Mod. Home ☐ Mobile Home ☐ Business ☐ Other
No. Bedrooms 4 No. Bathrooms 3 No. Employees


☑ Slab ☑ Crawl Space ☐ Basement w/plumbing ☐ Basement wo/plumbing

Water Supply: ☑ Individual ☐ Public ☐ Community

Comments:/Conditions: * ONE INSPECTION port PER Lateral. Remove any old burms, terraces, properly fill old road bed area. Do not remove any soil from drainfield area. Install septic system during dry conditions.

Comments:/Conditions: 340 Robinson Rd.

INITIAL SITE SKETCH

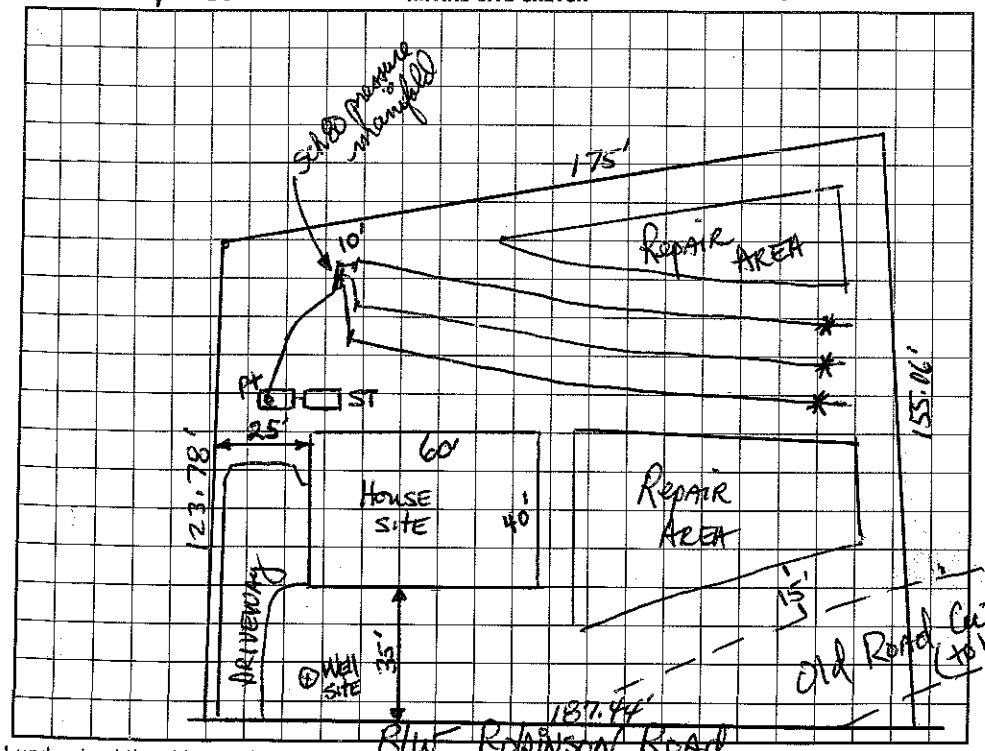

AS BUILT SKETCH

I understand that this permit can be suspended or revoked if any false information is supplied toward securing the permit/any unauthorized changes are made to the site/any unauthorized changes are made in the installation of the system. Improvement Permit with plat valid without expiration. Improvement Permit with site plan valid for sixty months. Authorization to Construct is valid for a period equal to that of Improvement Permit – not to exceed sixty months.

Signed: Frank DeSimone date 10-27-98 Installed by: FS Erwin

Improvement Permit by: date 10-25-98 Operation Permit by: Jeff Mayes date 3/24/99

Authorization to Construct by: date 10-25-98 Existing System Inspection by: date

HEALTH DEPT. COPY: WHITE INSPECTION COPY (FINAL): GREEN OWNER COPY (FINAL): YELLOW INSPECTION COPY (INITIAL): PINK OWNER COPY (INITIAL): GOLD