IREDELL COUNTY HEALTH DEPARTMENT

STATESVILLE 704-878-5305 MOORESVILLE 704-664-5281

IMPROVEMENT PERMIT / AUTHORIZATION TO CONSTRUCT / OPERATION PERMIT / EXISTING SYSTEM INSPECTION

PERMIT # 1062166 PIN # 4638-04-6369 DATE 4-26-11

OWNER or APPLICANT STEVE RIDGES PHONE: Business 704-881-4759 Home:

OWNER or APPLICANT ADDRESS 374 ROBINSON RD

LOCATION / DIRECTIONS 150 W, TR ROBINSON

SUBDIVISION ROBINSON WOODS BLOCK / SECTION LOT # 8 LOT AREA .61 AC DESIGN FLOW 360 L.T.A.R. 1.3

Septic Tank EX 1000 Gallons: STB Date

Pump Tank Gallons: P T Date

Pump Make Model Serial #

Nitrification Field No Fields No Lines Linear Feet 300'

Trench Width EXISTING Max Trench Bottom Depth Gravel Depth

☐ New System ☐ Repair ☐ Expansion System Type I II III IV V VI

System Description: 25% RED.

Repair System Description: SAME POOL

Maintenance Agreement Required ☐ YES ☒ NO

☒ GRAVITY ☐ PRESSURE

☒ Residence No. Bedrooms 3

☐ Business No. Persons

☒ Other No. Employees


☐ Slab ☒ Crawl Space

☐ Basement w/plumbing ☐ Basement w/o plumbing

Water Supply: ☒ Private ☐ Public ☐ Community


Comments / Conditions ① POOL (WATERS EDGE) MUST BE 15' FROM SEPTIC ② ALL OTHER PARTS OF POOL MUST BE MIN 5'

INITIAL SITE SKETCH

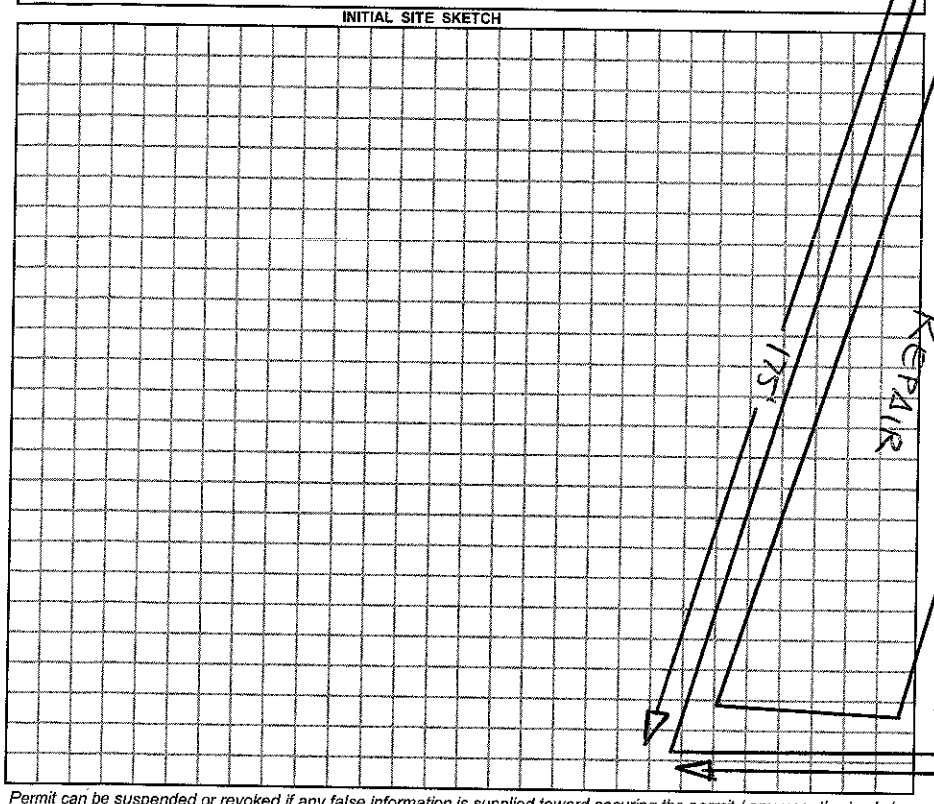

Comments / Conditions 131'

AS BUILT SKETCH

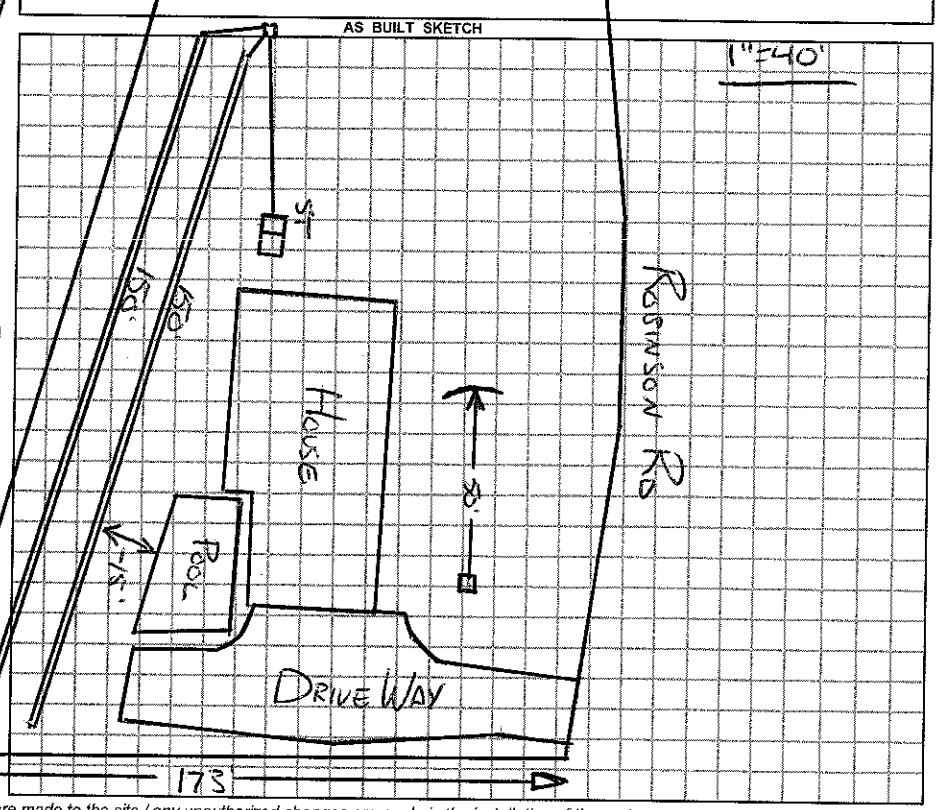

Permit can be suspended or revoked if any false information is supplied toward securing the permit / any unauthorized changes are made to the site / any unauthorized changes are made in the installation of the system.

☐ *IMPROVEMENT PERMIT w / plat valid without expiration.* ☐ *IMPROVEMENT PERMIT w / site plan valid for 60 mos.* ☐ *AUTHORIZATION TO CONSTRUCT valid for period equal to IMPROVEMENT PERMIT-not to exceed 60 mo.*

Owner / Applicant Signature: [signature] Date 4/26/11

Improvement Permit by: Date

Authorzation to Construct by: Date

YOU SHOULD CONTACT A LOCATOR SERVICE PRIOR TO ANY EXCAVATION.

Installed by:

Operation Permit by: Date:

Existing System Inspected by: [signature] REHS Date: 4-26-11

WHITE COPY Environmental Health YELLOW COPY (Final) Owner / Applicant PINK COPY (Initial) Owner / Applicant