130

# IREDELL COUNTY HEALTH DEPARTMENT

STATESVILLE 704-878-5305 MOORESVILLE 704-664-5281

## IMPROVEMENT PERMIT / AUTHORIZATION TO CONSTRUCT / OPERATION PERMIT / EXISTING SYSTEM INSPECTION

PERMIT# 075864 PIN# 4638-04-7050 DATE 2/25/05

OWNER OR CONTRACTOR Anaheim Homes, Inc PHONE: Business 704-907-9250 Home

ADDRESS Po Box 610 Statesville, NC 28687

LOCATION 150 W. TR Robinson Rd, on Rt

SUBDIVISION Robinson Woods BLOCK / SECTION LOT 4 LOT AREA 0.7 AC SITE CLASS. PS DESIGN FLOW 360 L.T.A.R. 0.3

Septic Tank: 1000 Gallons; STB 312 Date

Pump Tank: 1000 Gallons; PT 27 Date

Pump Make: Model Serial No.

Nitrification Field: No. Fields 1 Square Feet 900 Linear Feet 300'

No. Lines 4@75' Trench Width 36" Max Trench Bottom Depth 36" Gravel Depth —

[X] New System [ ] Repair System Type: I, II, (III) IV, V, VI

System Description: PM 25% Reduction

Repair System Description: 2P Panel Block

Maintenance Agreement Required: [ ] Yes [X] No

[X] House/Mod. Home No. Bedrooms 3

[ ] Mobile Home No. Bathrooms

[ ] Business No. Employees

[ ] Other

[ ] Slab [X] Crawl Space [ ] Basement w/plumbing [ ] Basement wo/plumbing


Water Supply: [X] Individual [ ] Public [ ] Community

Comments:/Conditions:


1"=50'

Comments:/Conditions:

INITIAL SITE SKETCH

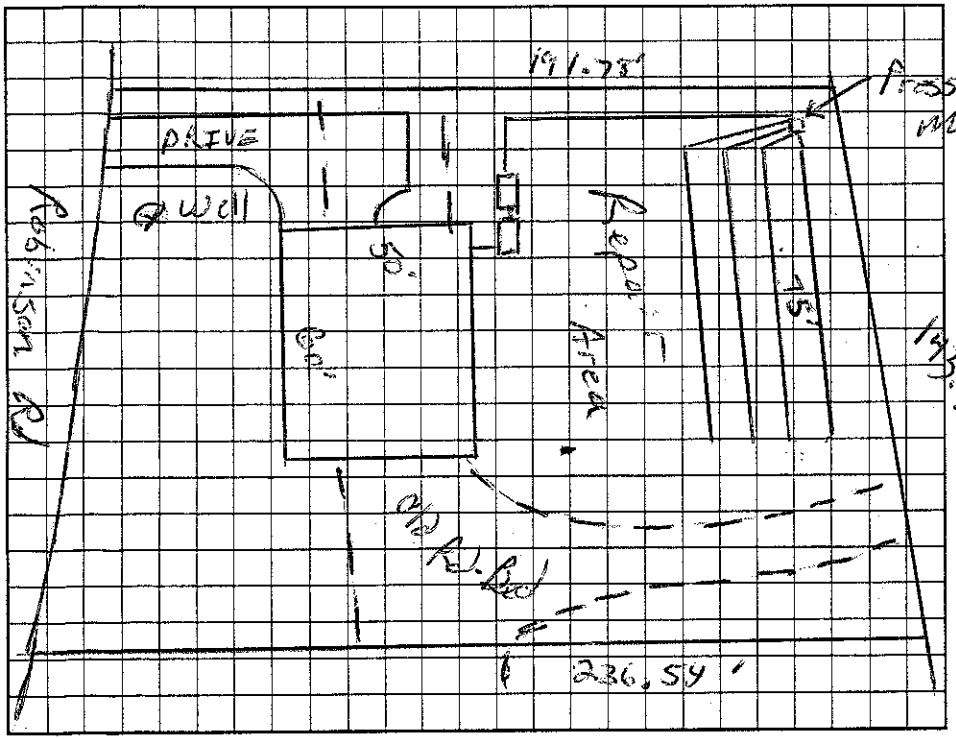


AS BUILT SKETCH

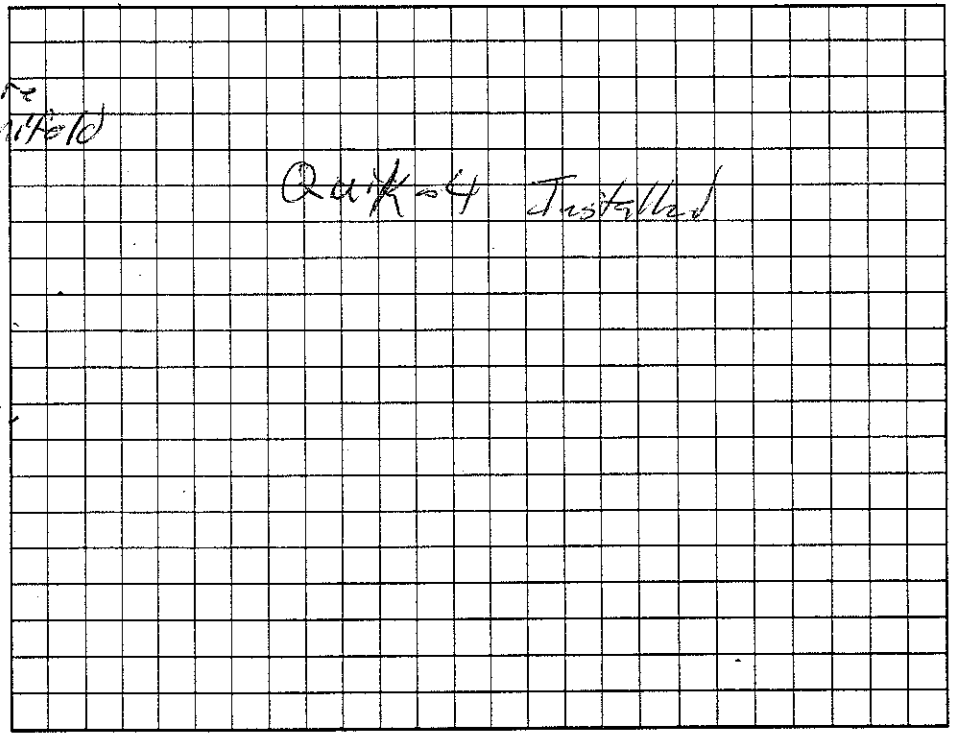


Permit can be suspended or revoked if any false information is supplied toward securing the permit/any unauthorized changes are made to the site/any unauthorized changes are made in the installation of the system. Improvement Permit with plat valid without expiration. Improvement Permit with site plan valid for sixty months. Authorization to Construct is valid for a period equal to that of Improvement Permit – not to exceed sixty months.

Signed: date 3/1/05 Installed by: Jackson Exc.

Improvement Permit by: RS date 2/25/05 Operation Permit by: RS date 4/18/05

Authorization to Construct by: RS date 2/25/05 Existing System Inspection by: date

HEALTH DEPT. COPY: WHITE OWNER COPY (FINAL): YELLOW OWNER COPY (INITIAL): PINK