IREDELL COUNTY HEALTH DEPARTMENT

STATESVILLE 704-878-5305 MOORESVILLE 704-664-5281

IMPROVEMENT PERMIT / AUTHORIZATION TO CONSTRUCT / OPERATION PERMIT / EXISTING SYSTEM INSPECTION

PERMIT# 075869 PIN# ~~4638038890~~ 4638 04 7287 DATE Oct. 16, '98

OWNER OR CONTRACTOR Frank Ndefemore PHONE: Business 788-6023 Home

ADDRESS 811 Rothmoor Dr. Concord, N.C. 28025

LOCATION 150W. TR Robinson Rd. on Right

SUBDIVISION Robinson Woods BLOCK / SECTION LOT 9 LOT AREA .66 Ac SITE CLASS. PS DESIGN FLOW 480gpd L.T.A.R. .3

Septic Tank: 1000 Gallons; STB 794 Date 3/30/99
Pump Tank: Gallons; PT Date
Pump Make: Model Serial No.
Nitrification Field: No Fields 1 Square Feet 1200 Linear Feet 400
No Lines 3@134' Trench Width 36" Max Trench Bottom Depth 30" Gravel Depth NA

☑ New System ☐ Repair System Type: I, II, (III), IV, V, VI
System Description: Gravity 25% Reduction
Repair System Description: Same
Maintenance Agreement Required: ☐ Yes ☑ No

☑ House/Mod. Home No. Bedrooms 4
☐ Mobile Home No. Bathrooms 3
☐ Business No. Employees
☐ Other


☐ Slab ☑ Crawl Space ☐ Basement w/plumbing ☐ Basement wo/plumbing

Water Supply: ☑ Individual ☐ Public ☐ Community

Comments:/Conditions: *ONE inspection port per LATERAL. Remove any old burms, terraces. Install septic system during dry conditions.

Comments:/Conditions:

INITIAL SITE SKETCH 1"=50'

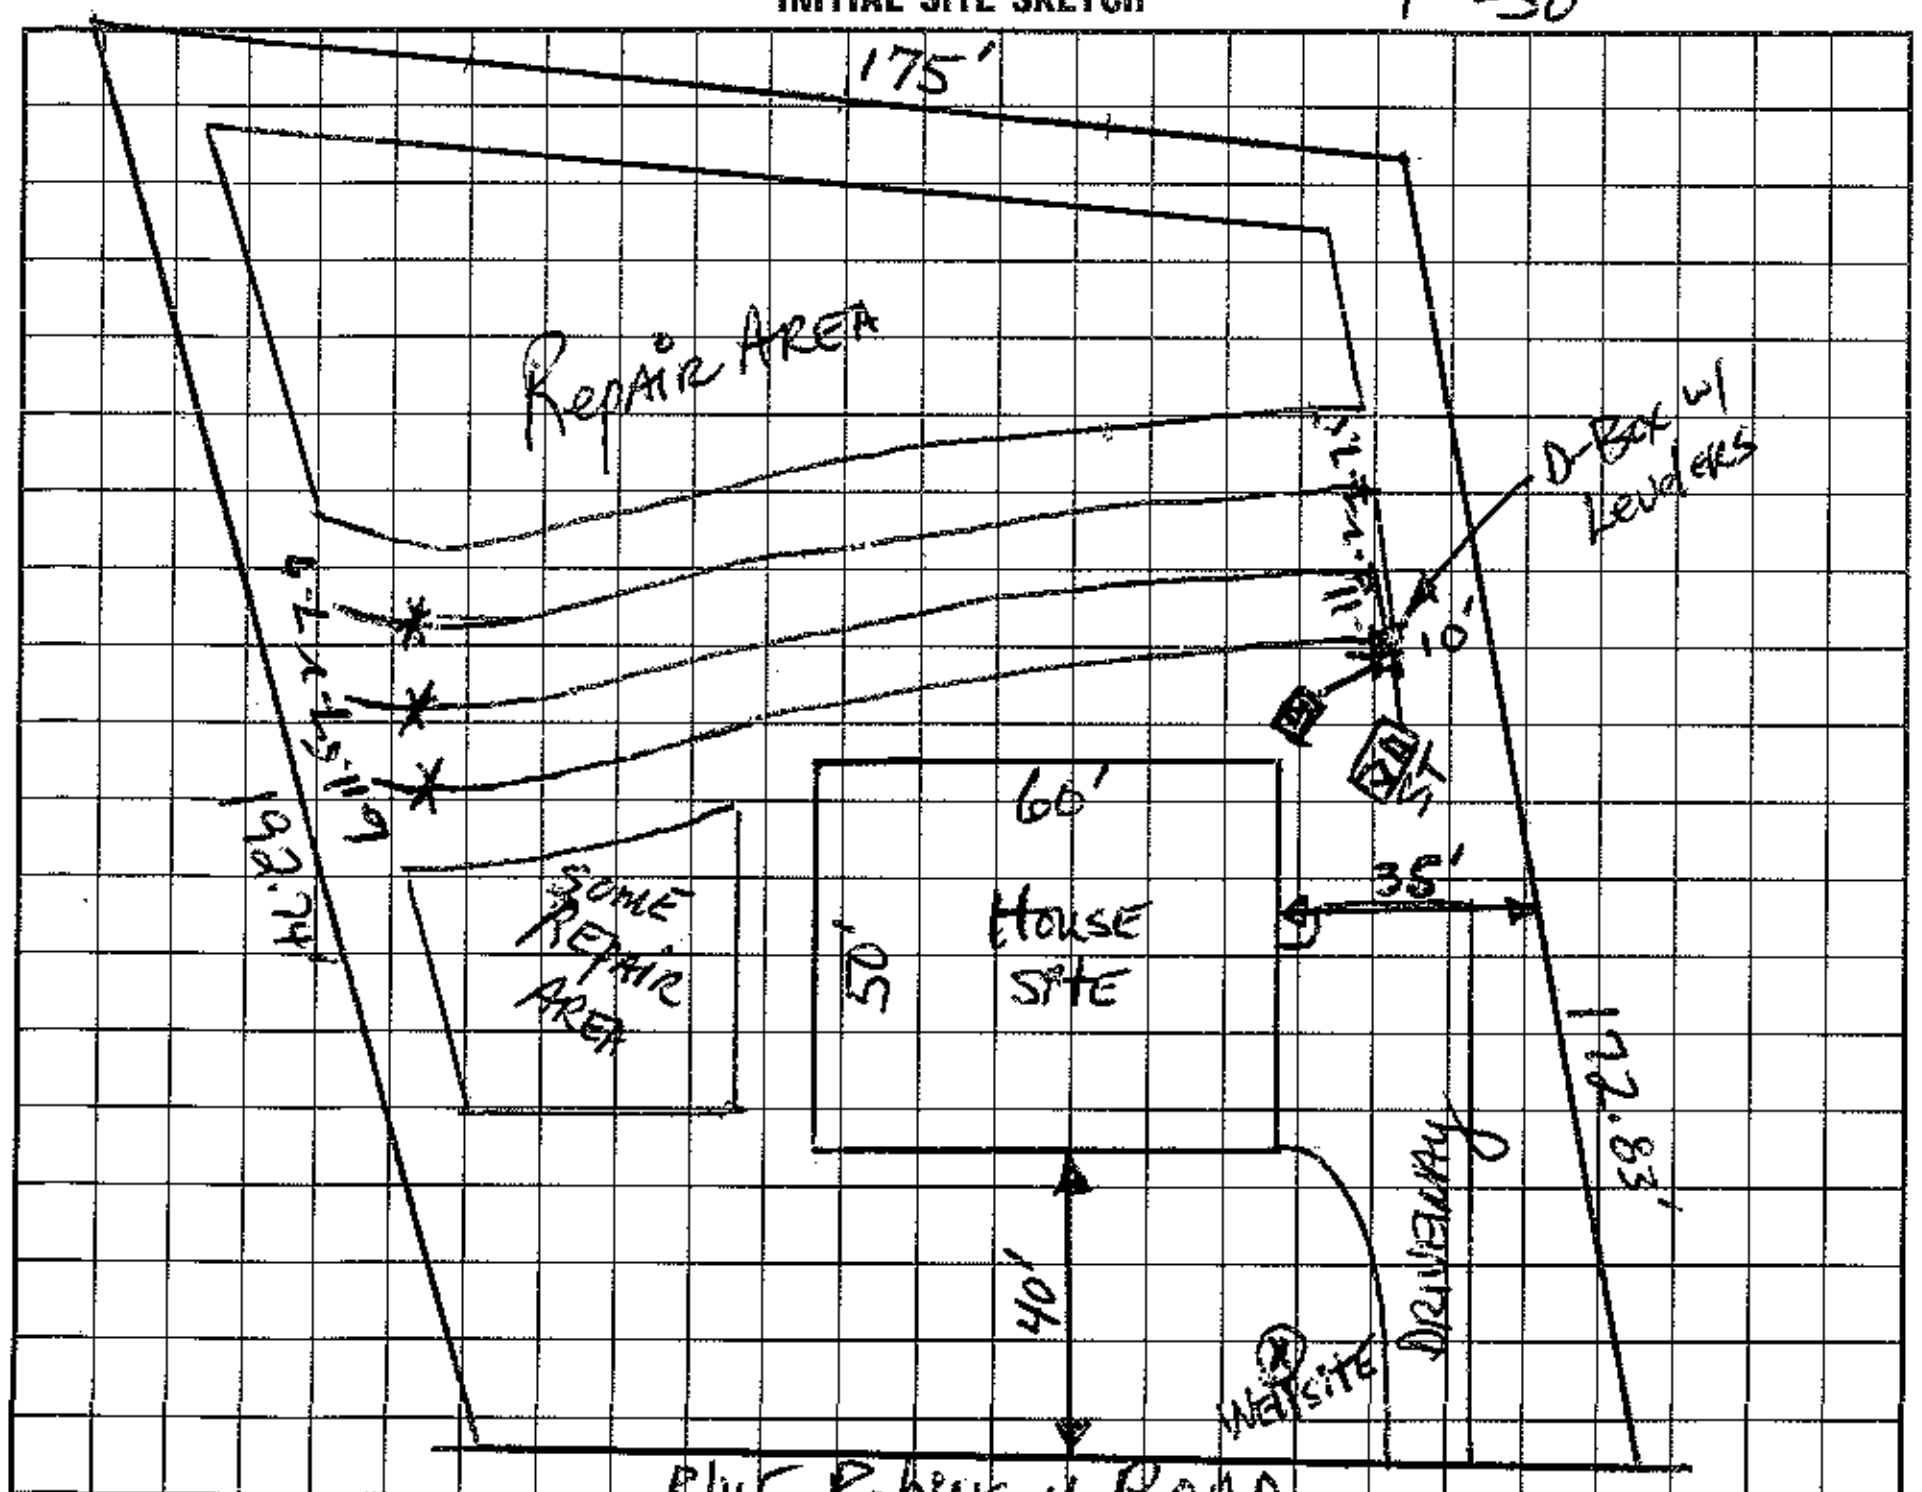

AS BUILT SKETCH

I understand that this permit can be suspended or revoked if any false information is supplied toward securing the permit/any unauthorized changes are made to the site/any unauthorized changes are made in the installation of the system. Improvement Permit with plat valid without expiration. Improvement Permit with site plan valid for sixty months. Authorization to Construct is valid for a period equal to that of Improvement Permit – not to exceed sixty months.

Signed: [signature] date 10-27-98 Installed by: F J Ervin

Improvement Permit by: [signature], RS date 10-16-98 Operation Permit by: Wesley Sparks RS date 7/16/99

Authorization to Construct by: [signature], RS date 10-16-98 Existing System Inspection by: date

HEALTH DEPT. COPY: WHITE INSPECTION COPY (FINAL): GREEN OWNER COPY (FINAL): YELLOW INSPECTION COPY (INITIAL): PINK OWNER COPY (INITIAL): GOLD