3:15

IREDELL COUNTY HEALTH DEPARTMENT

STATESVILLE 704-878-5305 MOORESVILLE 704-664-5281

IMPROVEMENT PERMIT / AUTHORIZATION TO CONSTRUCT / OPERATION PERMIT / EXISTING SYSTEM INSPECTION

PERMIT# 075870 PIN# 4638048198 DATE Oct 16, '98

OWNER OR CONTRACTOR Frank Mastimone Build PHONE: Business 788-6023 Home

ADDRESS 811 Rothmoor Dr. Concord N.C. 28025

LOCATION 150 W TR Robinson Rd. on Right

SUBDIVISION Robinson Woods BLOCK / SECTION LOT 10 LOT AREA .69 Ac SITE CLASS. PS DESIGN FLOW 460 gpd L.T.A.R. no. 3

Septic Tank: 1000 Gallons; STB 794 Date 9-4-99
Pump Tank: Gallons; PT Date
Pump Make: Model Serial No.
Nitrification Field: No Fields 1 Square Feet 1200 Linear Feet 460
No Lines 4 @ 100 Trench Width 36" Max Trench Bottom Depth 24"

☑ New System ☐ Repair System Type: I, II, III, IV, V, VI
System Description: Gravity 25% Reduction
Repair System Description: Gravity/pumped 25-50% Reduction
Maintenance Agreement Required: ☐ Yes ☑ No
Gravel Depth NA


☑ House/Mod. Home No. Bedrooms 4
☐ Mobile Home No. Bathrooms 3
☐ Business No. Employees
☐ Other
☐ Slab ☑ Crawl Space ☐ Basement w/plumbing ☐ Basement wo/plumbing

Water Supply: ☑ Individual ☐ Public ☐ Community

Comments/Conditions: * ONE INSPECTION PORT PER LATERAL
Remove any old storm, terraces. Install septic system during dry conditions.

Comments/Conditions: Inspection ports installed, filter & riser installed.
Well was installed.

INITIAL SITE SKETCH 1"=50'

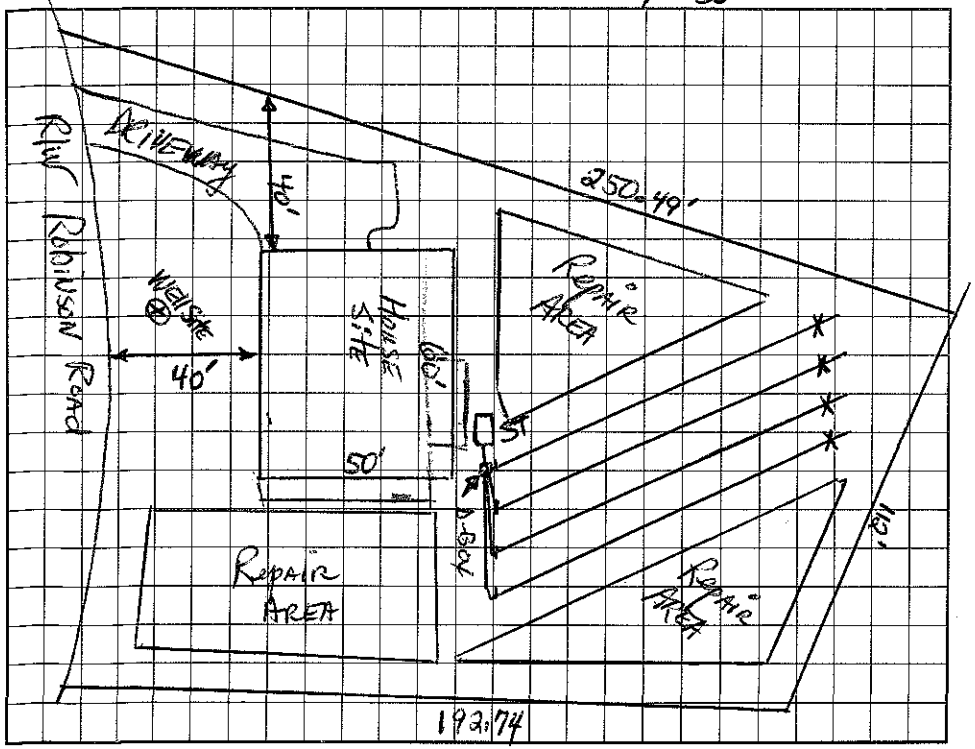

AS BUILT SKETCH

Installed as Drawn
Note: See permit for Addition Repair Now Panel Block

I understand that this permit can be suspended or revoked if any false information is supplied toward securing the permit/any unauthorized changes are made to the site/any unauthorized changes are made in the installation of the system. Improvement Permit with plat valid without expiration. Improvement Permit with site plan valid for sixty months. Authorization to Construct is valid for a period equal to that of Improvement Permit – not to exceed sixty months.

Signed: Thomas Brooks date 10-22-98
Improvement Permit by: Donald R. Amon, RS date 10-16-98
Authorization to Construct by: Donald R. Amon, RS date 10-16-98

Installed by: Larry Beam Grading
Operation Permit by: Melissa H. Dotson RS date 10/15/99
Existing System Inspection by: date

HEALTH DEPT. COPY: WHITE INSPECTION COPY (FINAL): GREEN OWNER COPY (FINAL): YELLOW INSPECTION COPY (INITIAL): PINK OWNER COPY (INITIAL): GOLD