3115

IREDELL COUNTY HEALTH DEPARTMENT

STATESVILLE 704-878-5305 MOORESVILLE 704-664-5281

IMPROVEMENT PERMIT / AUTHORIZATION TO CONSTRUCT / OPERATION PERMIT / EXISTING SYSTEM INSPECTION

PERMIT# 075870 PIN# 4638046198 DATE Oct 16, 98

OWNER OR CONTRACTOR Frank Mesimore Build PHONE: Business 788-6023 Home

ADDRESS 811 Rothmoor Dr. Concord N.C. 28025

LOCATION 650 W TR Robinson Rd. on Right

SUBDIVISION Robinson Woods BLOCK / SECTION LOT 10 LOT AREA .69 Ac SITE CLASS PS DESIGN FLOW 480 gpd L.T.A.R. no.3

Septic Tank: 1000 Gallons; STB 794 Date 9-4-99

Pump Tank: Gallons; PT Date

Pump Make: Model Serial No.

Nitrification Field: No Fields 1 Square Feet 1200 Linear Feet 400

No Lines 4 @ 100' Trench Width 36" Max Trench Bottom Depth 24" Gravel Depth NA

☑ New System ☐ Repair System Type: I, II, III, IV, V, VI

System Description: Gravity 25% Reduction

Repair System Description: Grav/pumped 25-50% Reduction

Maintenance Agreement Required: ☐ Yes ☑ No

☑ House/Mod. Home No. Bedrooms 4

☐ Mobile Home No. Bathrooms 3

☐ Business No. Employees

☐ Other


☐ Slab ☑ Crawl Space ☐ Basement w/plumbing ☐ Basement wo/plumbing

Water Supply: ☑ Individual ☐ Public ☐ Community

Comments/Conditions: *ONE INSPECTION cost PER LATERAL
Remove any old barns, terraces. clean septic system during dry conditions.

Comments:/Conditions: Inspection ports installed, filter and riser installed.
Well was installed.

INITIAL SITE SKETCH 1"=50'

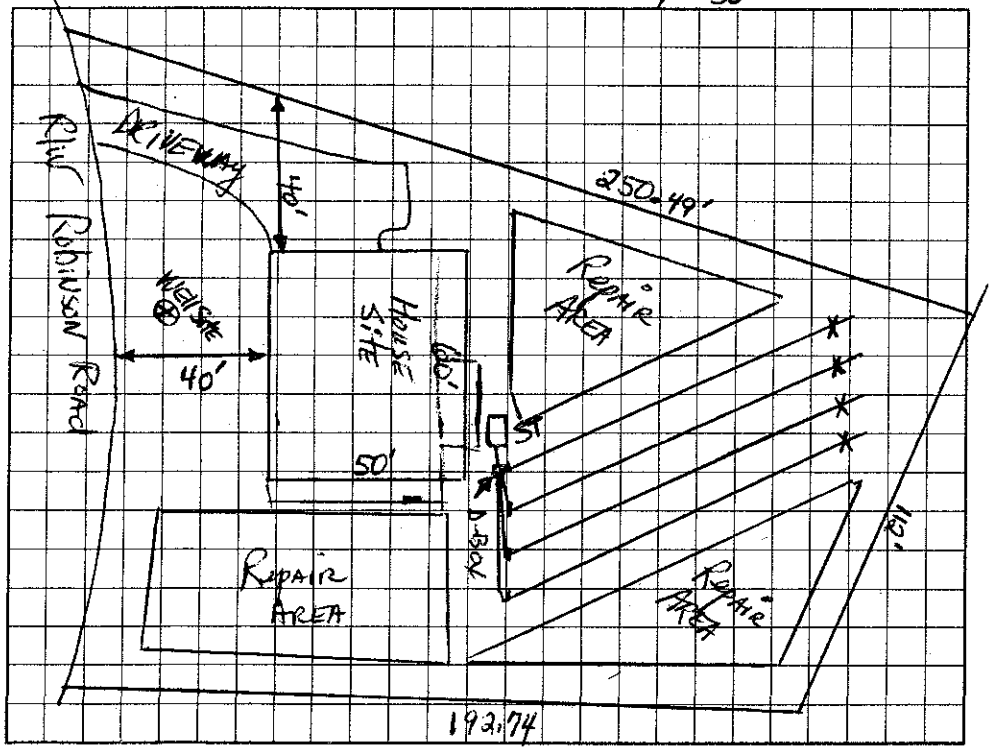

AS BUILT SKETCH

Installed as Drawn
Original
Permit for
Existing House

I understand that this permit can be suspended or revoked if any false information is supplied toward securing the permit/any unauthorized changes are made to the site/any unauthorized changes are made in the installation of the system. Improvement Permit with plat valid without expiration. Improvement Permit with site plan valid for sixty months. Authorization to Construct is valid for a period equal to that of Improvement Permit – not to exceed sixty months.

Signed: Thomas Beaty date 10-27-98

Improvement Permit by: RS date 10-16-98

Authorization to Construct by: RS date 10-16-98

Installed by: Larry Beam Grading

Operation Permit by: RS date 10/15/99

Existing System Inspection by: date

HEALTH DEPT. COPY: WHITE INSPECTION COPY (FINAL): GREEN OWNER COPY (FINAL): YELLOW INSPECTION COPY (INITIAL): PINK OWNER COPY (INITIAL): GOLD