IREDELL COUNTY HEALTH DEPARTMENT

STATESVILLE 704-878-5305 MOORESVILLE 704-664-5281

IMPROVEMENT PERMIT / AUTHORIZATION TO CONSTRUCT / OPERATION PERMIT / EXISTING SYSTEM INSPECT.

PERMIT# 078249 PIN# 4638049408 DATE 2/18/99

OWNER OR CONTRACTOR VIRGENIA HELMS PHONE: Business Home 664-9117

ADDRESS 383 ROBERSON RD. MOORESVILLE NC 28117

LOCATION 150W-TR ROBERSON RD-~1 mile on LT

SUBDIVISION CUST BLOCK / SECTION 11 LOT 186 LOT AREA .71AC SITE CLASS. 5 DESIGN FLOW 240 L.T.A.R. .3

Septic Tank: 1000 Gallons; STB 180 Date 7/12/99
Pump Tank: Gallons; PT Date
Pump Make: Model Serial No.
Nitrification Field: No Fields 1 Square Feet 368 Linear Feet 134
No Lines 2@67' Trench Width 24" Max Trench Bottom Depth 36" Gravel Depth N/A

☑ New System ☐ Repair System Type: I, II, (III) IV, V, VI
System Description: GRAVITY PANELS
Repair System Description: EXEMPT FROM REPAIR
Maintenance Agreement Required: ☐ Yes ☑ No


☑ House/Mod. Home No. Bedrooms 2
☐ Mobile Home No. Bathrooms 2
☐ Business No. Employees
☐ Other
☐ Slab ☐ Crawl Space ☑ Basement w/plumbing ☐ Basement wo/plumbing

Water Supply: ☑ Individual ☐ Public ☐ Community

Comments:/Conditions: EXISTING- SYSTEM TO BE ABANDONED PROPERLY.

Comments:/Conditions:

INITIAL SITE SKETCH ~1"=60'

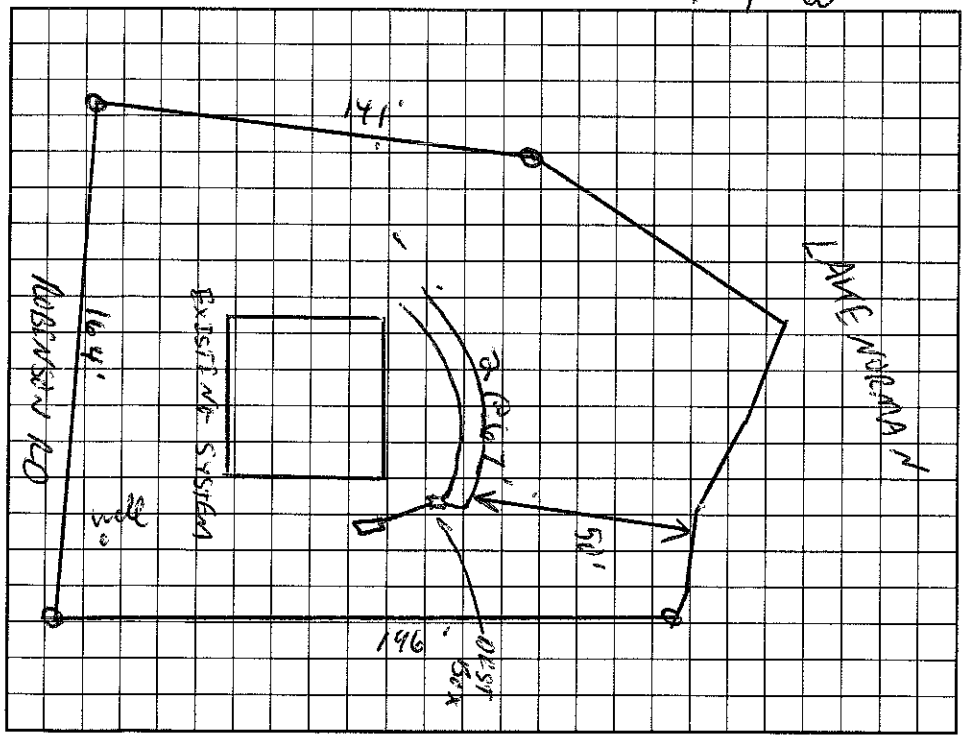

AS BUILT SKETCH

Permit can be suspended or revoked if any false information is supplied toward securing the permit/any unauthorized changes are made to the site/any unauthorized changes are made in the installation of the system. Improvement Permit with plat valid without expiration. Improvement Permit with site plan valid for sixty months. Authorization to Construct is valid for a period equal to that of Improvement Permit – not to exceed sixty months.

Signed: Virginia B. Stallings (Helms) date 02-23-99 Installed by: Miller Septic Tank

Improvement Permit by: C. [signature] RS date 2/18/99 Operation Permit by: Wesley Sparks RS. date 10/27/99

Authorization to Construct by: C. [signature] RS date 2/18/99 Existing System Inspection by: date

HEALTH DEPT. COPY: WHITE OWNER COPY (FINAL): YELLOW OWNER COPY (INITIAL): PINK