3 of

IREDELL COUNTY HEALTH DEPARTMENT

Authorization to Construct

STATESVILLE 704-878-5305 MOORESVILLE 704-664-5281

IMPROVEMENT PERMIT / ~~CERTIFICATE OF COMPLETION~~ / OPERATION PERMIT / EXISTING SYSTEM INSPECTION

PROPERTY DESCRIPTION NO. 26380 DATE 4/2/97 TAX MAP NO. 4638 06 9698 Watershed: [X] Yes [ ] No

OWNER OR CONTRACTOR Richard Blaze PHONE: Business _____ Home 910-765-4929

ADDRESS 530 Archer Dr. Winston-Salem, NC. 27107

LOCATION Broadview loop (L) off Fernhill Rd. (L) mailbox #159 (L), bear (R) to lowest house

SUBDIVISION CL+T BLOCK / SECTION 15 LOT 81 LOT AREA Existing SITE CLASS. PS DESIGN FLOW 480 L.T.A.R. .3

Septic Tank: Existing Gallons; STB _____ Date _____

Pump Tank: _____ Gallons; PT _____ Date _____

Pump Make: _____ Model _____ Serial No. _____

Nitrification Field: No Fields 1 Square Feet 500 Linear Feet 150

No Lines 3 Trench Width 10' Max Trench Bottom Depth 36" Gravel Depth 12"

[ ] New System [X] Repair System Type: I II III IV, V, VI

System Description: Gravity Bed - Flow Divider

Repair System Description: _____

Maintenance Agreement Required: [ ] Yes [X] No

[X] House/Mod. Home No. Bedrooms 4

[ ] Mobile Home No. Bathrooms 2.5

[ ] Business No. Employees _____

[ ] Other _____


[ ] Slab [X] Crawl Space [ ] Basement w/plumbing [ ] Basement wo/plumbing

Water Supply: [X] Individual [ ] Community [ ] Public


Comments:

Comments:

INITIAL SITE SKETCH

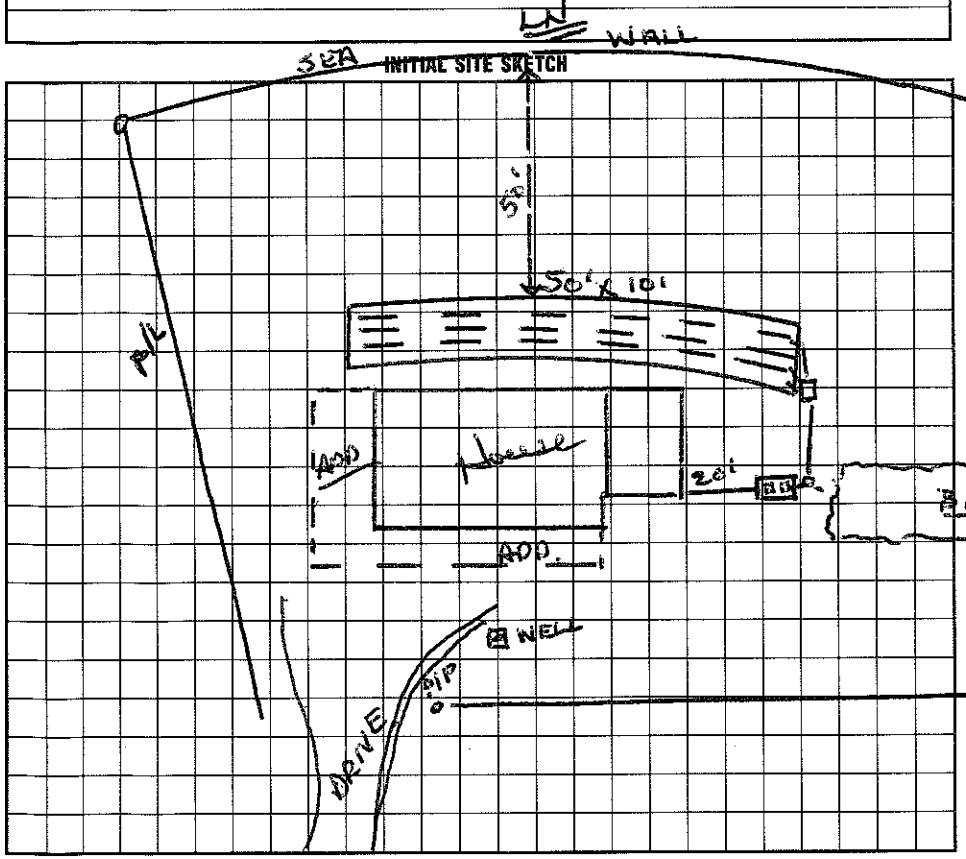

AS BUILT SKETCH

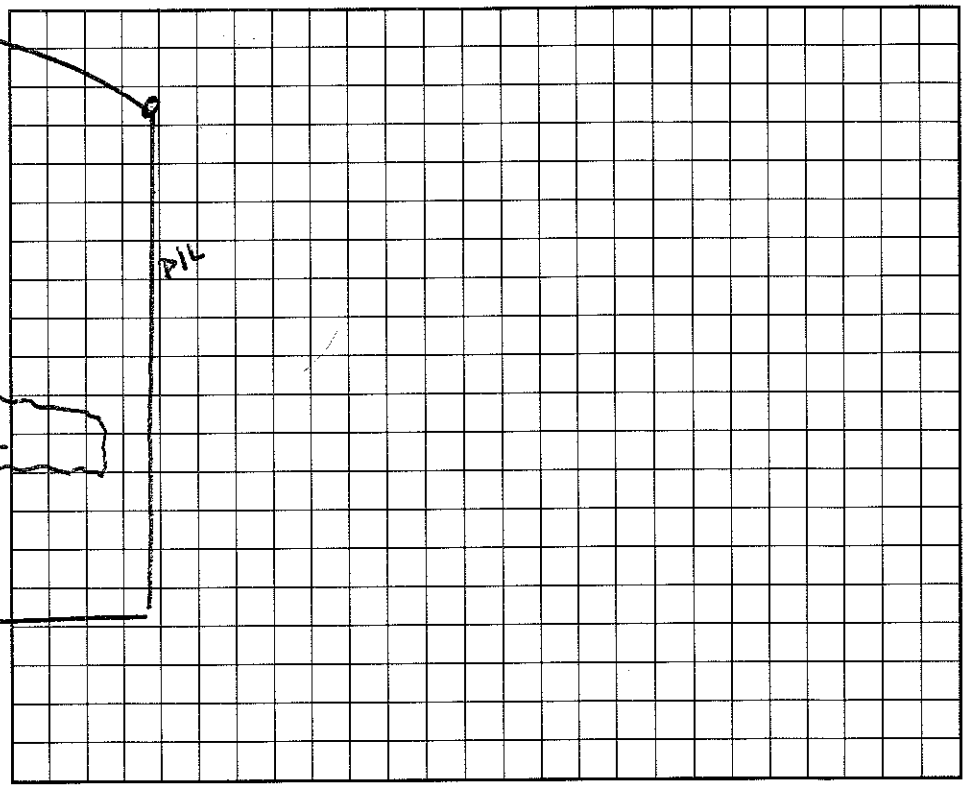

I understand that this permit can be suspended or revoked if any false information is supplied toward securing the permit/any unauthorized changes are made to the site/any unauthorized changes are made in the installation of the system. Improvement Permit is valid for 60 months from date of issuance.

Signed: [signature]

Improvement Permit by: Wesley Sparks RS. date 4/2/97

Existing System Inspection by: Wesley Sparks RS. date 4/2/97

Installed by: Forrest Shuford

Certificate of Completion by: Wesley Sparks RS. date 6/26/97

Operation Permit by: Wesley Sparks RS date 6/26/97

HEALTH DEPT. COPY: WHITE INSPECTION COPY (FINAL): GREEN OWNER COPY (FINAL): YELLOW INSPECTION COPY (INITIAL): PINK OWNER COPY (INITIAL): GOLD