IREDELL COUNTY HEALTH DEPARTMENT

Statesville Office (704) 878-5305 | Mooresville Office (704) 660-3625

IMPROVEMENT PERMIT / AUTHORIZATION TO CONSTRUCT / OPERATION PERMIT / EXISTING SYSTEM

SA Joe 980 722-0287

PERMIT # 213257

APPLICANT: Robert Herrick

PIN # 4638-06-9850.000 V

APPLICANT ADDRESS: 165 Broadview Cir. Mooresville NC

SITE ADDRESS: 165 Broadview Cir. Mooresville NC

PHONE: 704-528-4821 ALT. PHONE:

SITE DIRECTIONS: Keith Rd N, TL Fern Hill, TL Broadview Cir, Site on L

SUBDIVISION: CL;T

SECTION: 15 LOT # 82 LOT AREA: .750 Acre DESIGN FLOW: 360 GPD. L.T.A.R.: .3

Septic Tank	1000 (gal)	STB	825	Date	10-1995	☐ New System ☐ Repair ☒ Expansion	System Type: I II (III) IV V VI
Pump Tank	(gal)	PT		Date		System Description:	Gravity - 25% Reduction
Pump Make		Model		Serial #		Repair System Description:	LP-PPBPS
# Nitrification Fields	1	# Lines	2 @ 50'	Linear Ft:	100'	Maintenance Agreement Required:	☐ YES ☒ NO
Trench Width	36"	Max. Trench Bottom Depth	* 27" * Low Side	Gravel Depth	N/A	☒ GRAVITY	☐ PRESSURE

☒ Residence ☐ Business ☐ Other ☐ Slab ☒ Basement w/plumbing ☐ Basement w/o plumbing

No. Bedrooms 3 No. Persons 6 No. Employees ☐ Crawl Space

Water Supply: ☒ Private ☐ Public ☐ Community


Comments / Conditions:

Crush & Fill Existing Septic Tank. Install New Tank And New Drop Box To Serial Distribute To Existing 4'x 40' Bed System Then Flow To New


25% Reduction.

Existing Mobile Home Must Be Removed Prior To Issuance of OP.

INITIAL SITE SKETCH

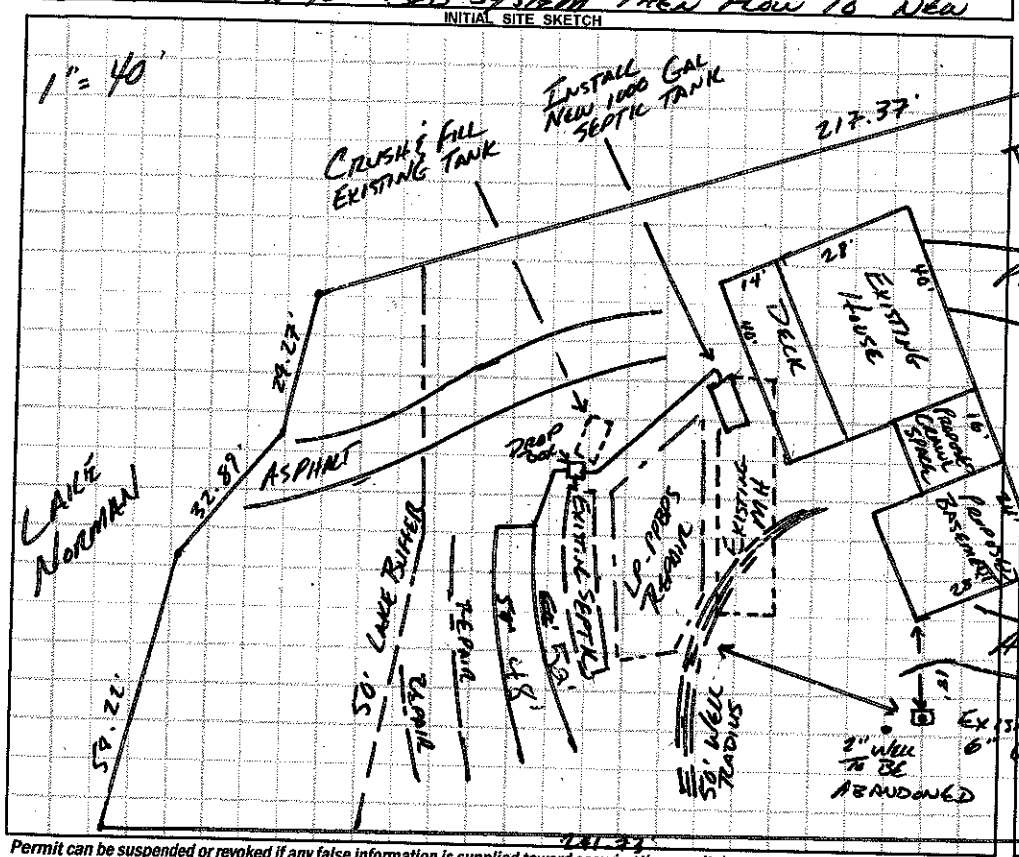

AS BUILT SKETCH

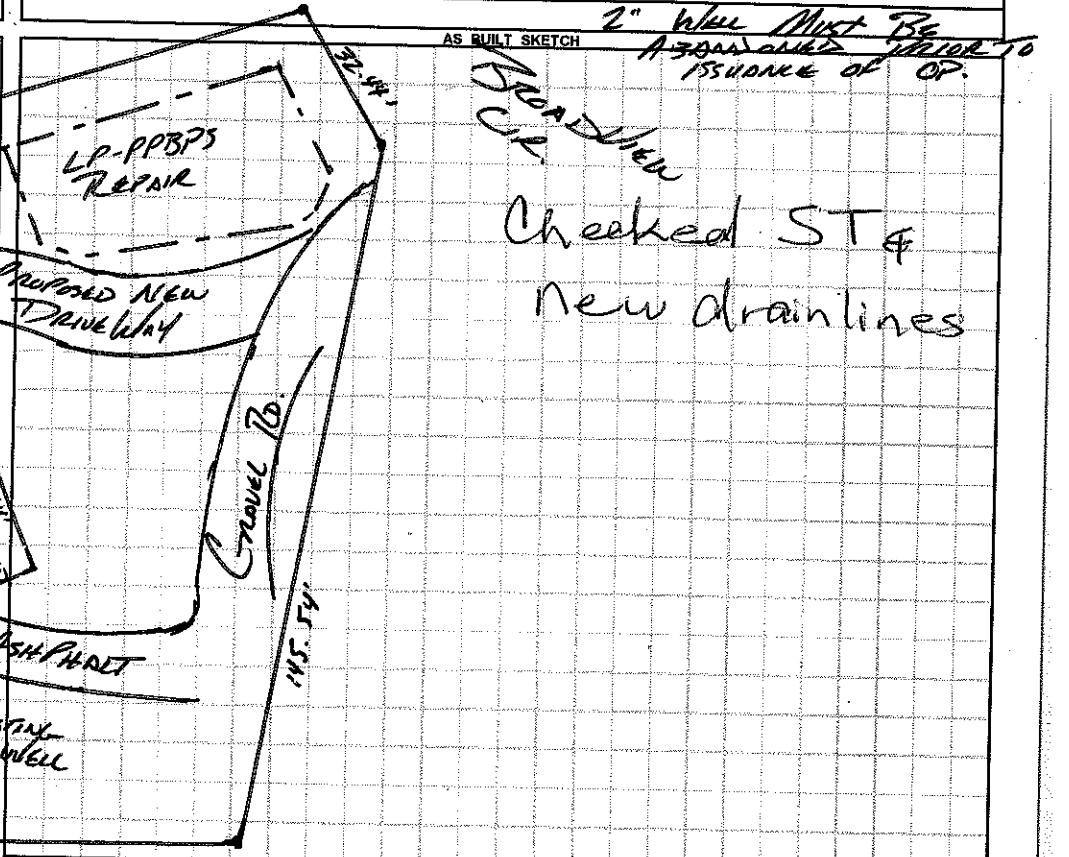

Permit can be suspended or revoked if any false information is supplied toward securing the permit / any unauthorized changes are made to the site / any unauthorized changes are made in the installation of the system. **CONTACT A LOCATOR SERVICE PRIOR TO ANY EXCAVATION**

☐ **IMPROVEMENT PERMIT** *with plat valid without expiration.*

☒ **IMPROVEMENT PERMIT** *with site plan valid for 60 mos.*

☒ **AUTHORIZATION TO CONSTRUCT** *valid for period equal to IMPROVEMENT PERMIT--not to exceed 60 mo.*

Owner / Applicant Signature: [signature] Date: 1-29-16

IMPROVEMENT PERMIT by: [signature] Date: JAN 25 2016

AUTHORIZATION TO CONSTRUCT by: [signature] Date: JAN 25 2016

Installed by: Joe Thompson

OPERATION PERMIT by: Maria Dotson RS Date: 2/12/16

Existing System Inspected by: Date:

Health Dept. Copy - WHITE Applicant (Final Approval) - YELLOW Applicant (Conditional Approval) - PINK