IREDELL COUNTY HEALTH DEPARTMENT

Statesville Phone TR 3-7271 Mooresville Phone No. 664-5281

PERMIT TO INSTALL SEPTIC TANK

Permit No. 195 Permit Date 8-7 1973

Owner Dean Redmond Address Statesville N.C.

Installed By Lackey Bro Address Stony Point N.C.


Location of Property Perth Church Rd to Bells X Rd
Turn on Rd 1300 (Fern Hill Ch Rd) T.R. on Holly Dr
Section # 15 Lot # 111 - House on L.

Tank		Capacity		Length of Lines		Fixtures	
Block	( )	1000	(✓)	225'	( )	No. of Baths	(1)
Precast	(✓)	1250	( )	250'	( )	Dishwasher	(–)
		1500	( )	Other 164		Garbage Grdr.	(–)
		Other				Other	

NOTIFY HEALTH DEPARTMENT AT LEAST EIGHT HOURS BEFORE TANK IS TO BE INSPECTED.

Final Inspection 8-7 1973 Approved (✓) Disapproved ( )

Remarks No Well at Time of inspection

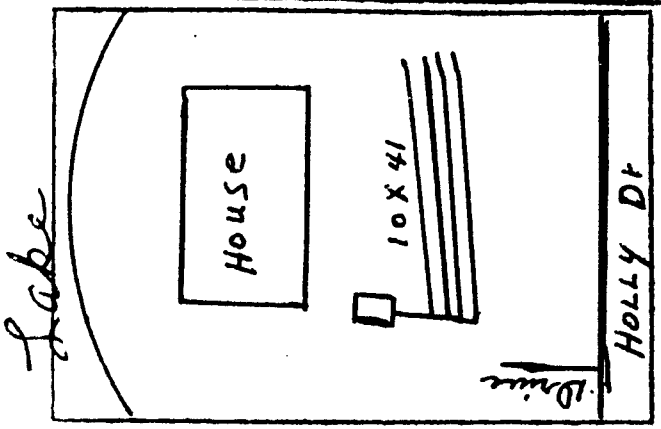

Sketch of Installation

Lines are deep.
Hit Well dirt in bottom of Ditch.
17 inches stone used in ditch.

E. A. Stevenson
Sanitarian