Redraw owes 305.00

11:30

IREDELL COUNTY HEALTH DEPARTMENT

STATESVILLE 704-878-5305 MOORESVILLE 704-664-5281

IMPROVEMENT PERMIT / AUTHORIZATION TO CONSTRUCT / OPERATION PERMIT / EXISTING SYSTEM INSPECTION

PERMIT# 147980 PIN# 4638070921.000 DATE 8/13/08

OWNER OR APPLICANT Artisan Custom Homes PHONE: Business 704 987-9369 Home

ADDRESS PO Box 2212 Davidson NC 28036

LOCATION Perth Rd. N TL Fern Hill Rd. TR St Charles Ln at end on Left

SUBDIVISION CLFT BLOCK / SECTION 15 LOT 111 LOT AREA .8 ac SITE CLASS. PS DESIGN FLOW 480 L.T.A.R. .3

Septic Tank: 1000 Gallons; STB 794 Date 1-19-09
Pump Tank: 1000 Gallons; PT 283 Date 2-1-08
Pump Mak Myers Model ME 50S2 No. (Myers)
Nitrification Field/No Fields 1 Square Feet 540 Linear Feet 270'
No Lines 5 Trench Width 24" Max Trench Bottom Depth 36"


☑ New System ☐ Repair ☐ Expansion System Type: I II III (IV) V VI
System Description: LP-PPBPS
Repair System Description: same
Maintenance Agreement Required: ☑ Yes ☐ No
Gravel Depth N/A ☐ Gravity ☑ Pressure

☑ House/Mod. Home ☐ Mobile Home ☐ Business ☐ Other
No. Bedrooms 4 No. Persons No. Employees
Water Supply: ☑ Individual ☐ Public ☐ Community
☐ Slab ☐ Crawl Space ☑ Basement w/plumbing ☐ Basement wo/plumbing


Comments:/Conditions: * Maintain 25' min separation of Septic from cut of basement. * Exis drain to be relocated away from well area. (* See Attached SAME plan.)

Comments:/Conditions: * Use existing driveway, Buildup/Fill Driveway to be even with ends of drainlines. Do not fill in drainfield Area. * Fence off Septic areas during Construction. * Main floor office must have cased doorway w/ O.P.

INITIAL SITE SKETCH

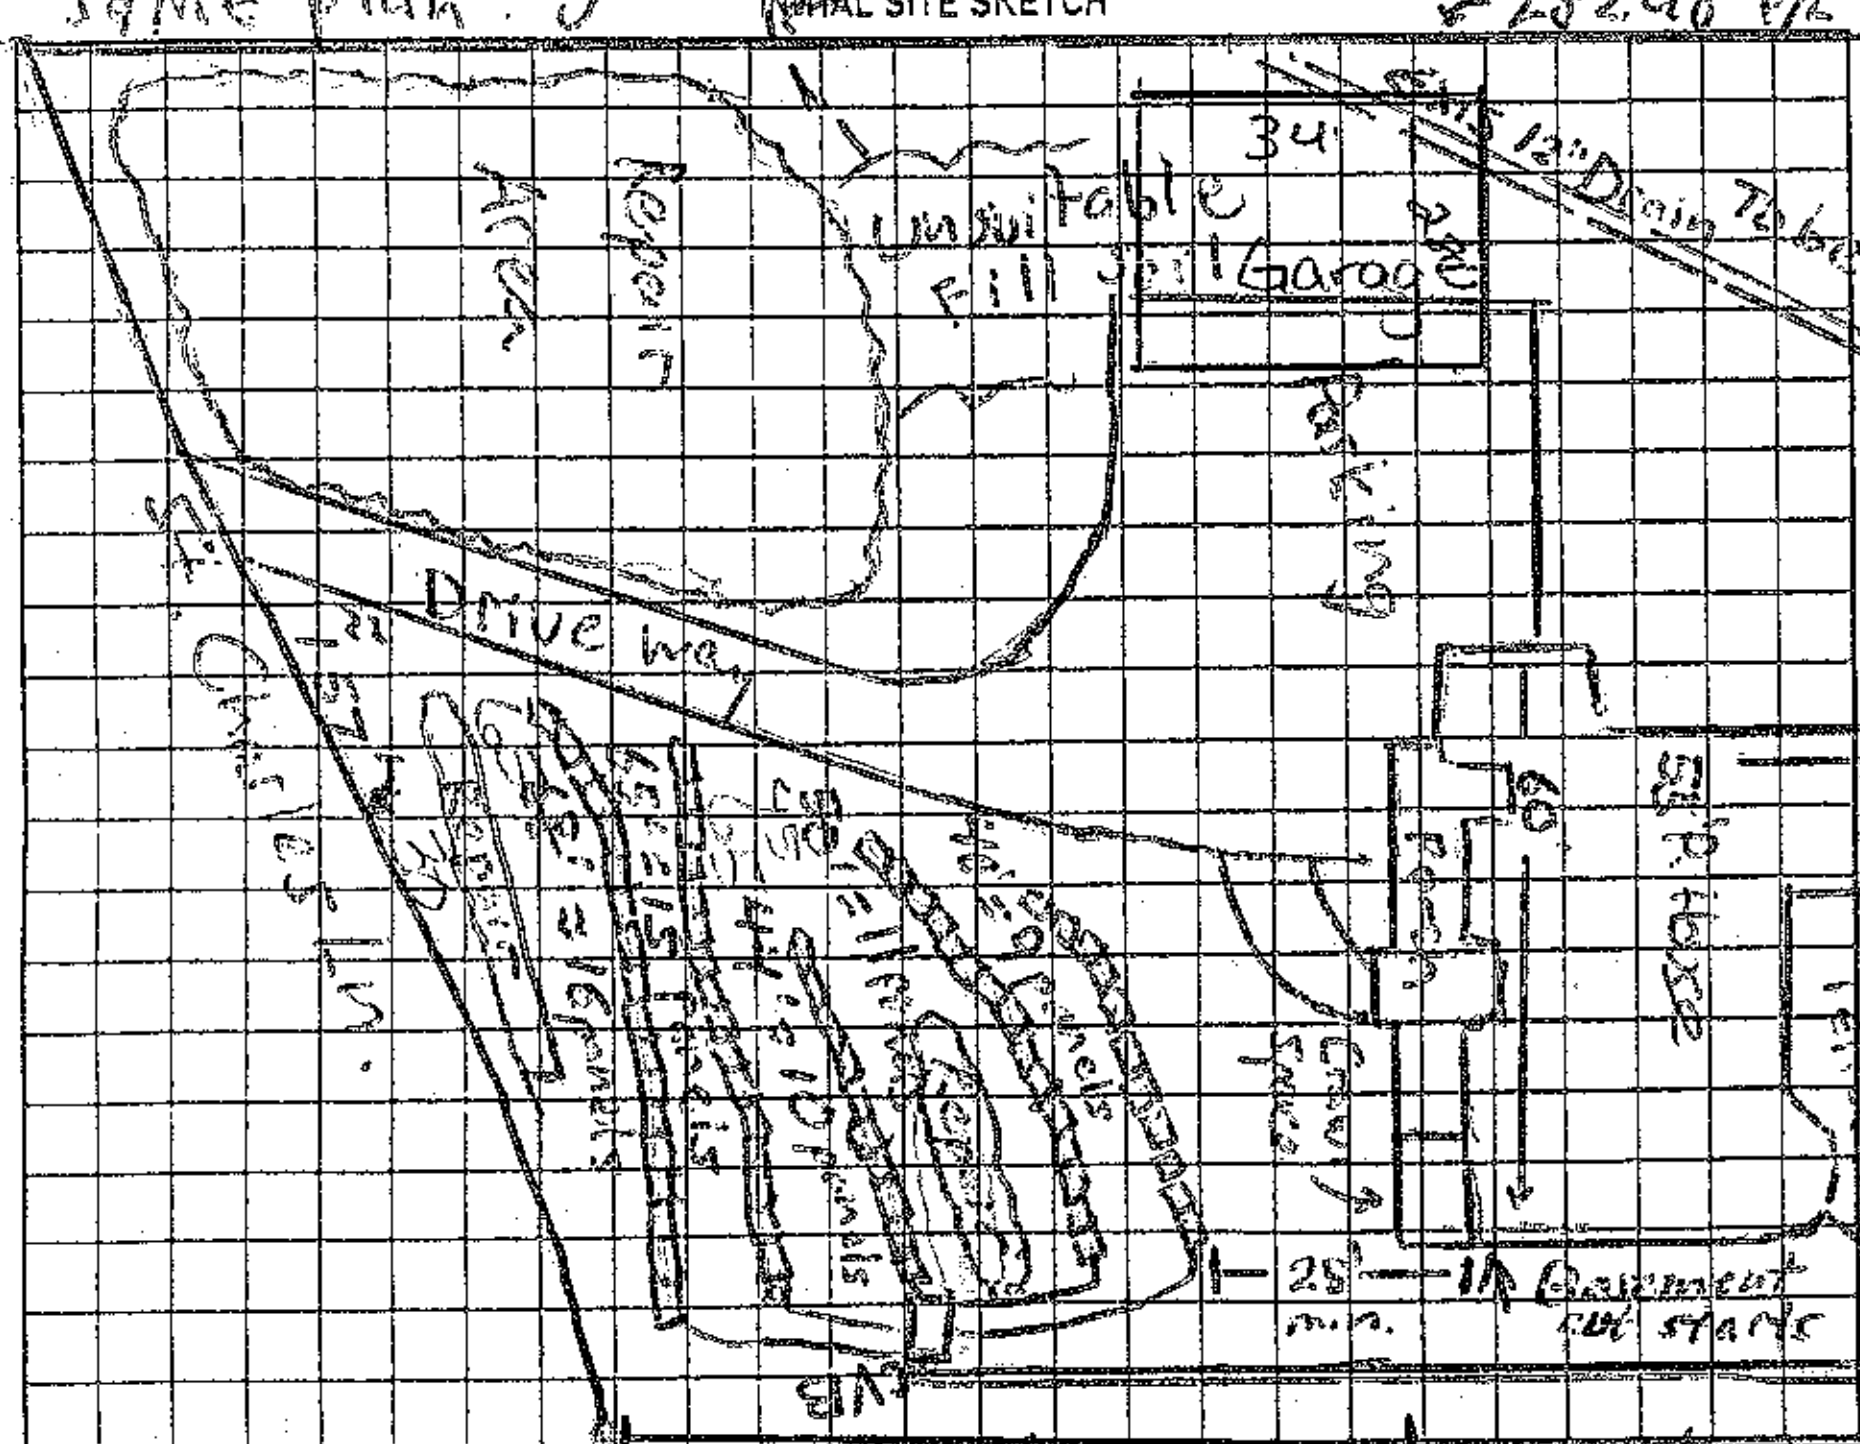

AS BUILT SKETCH

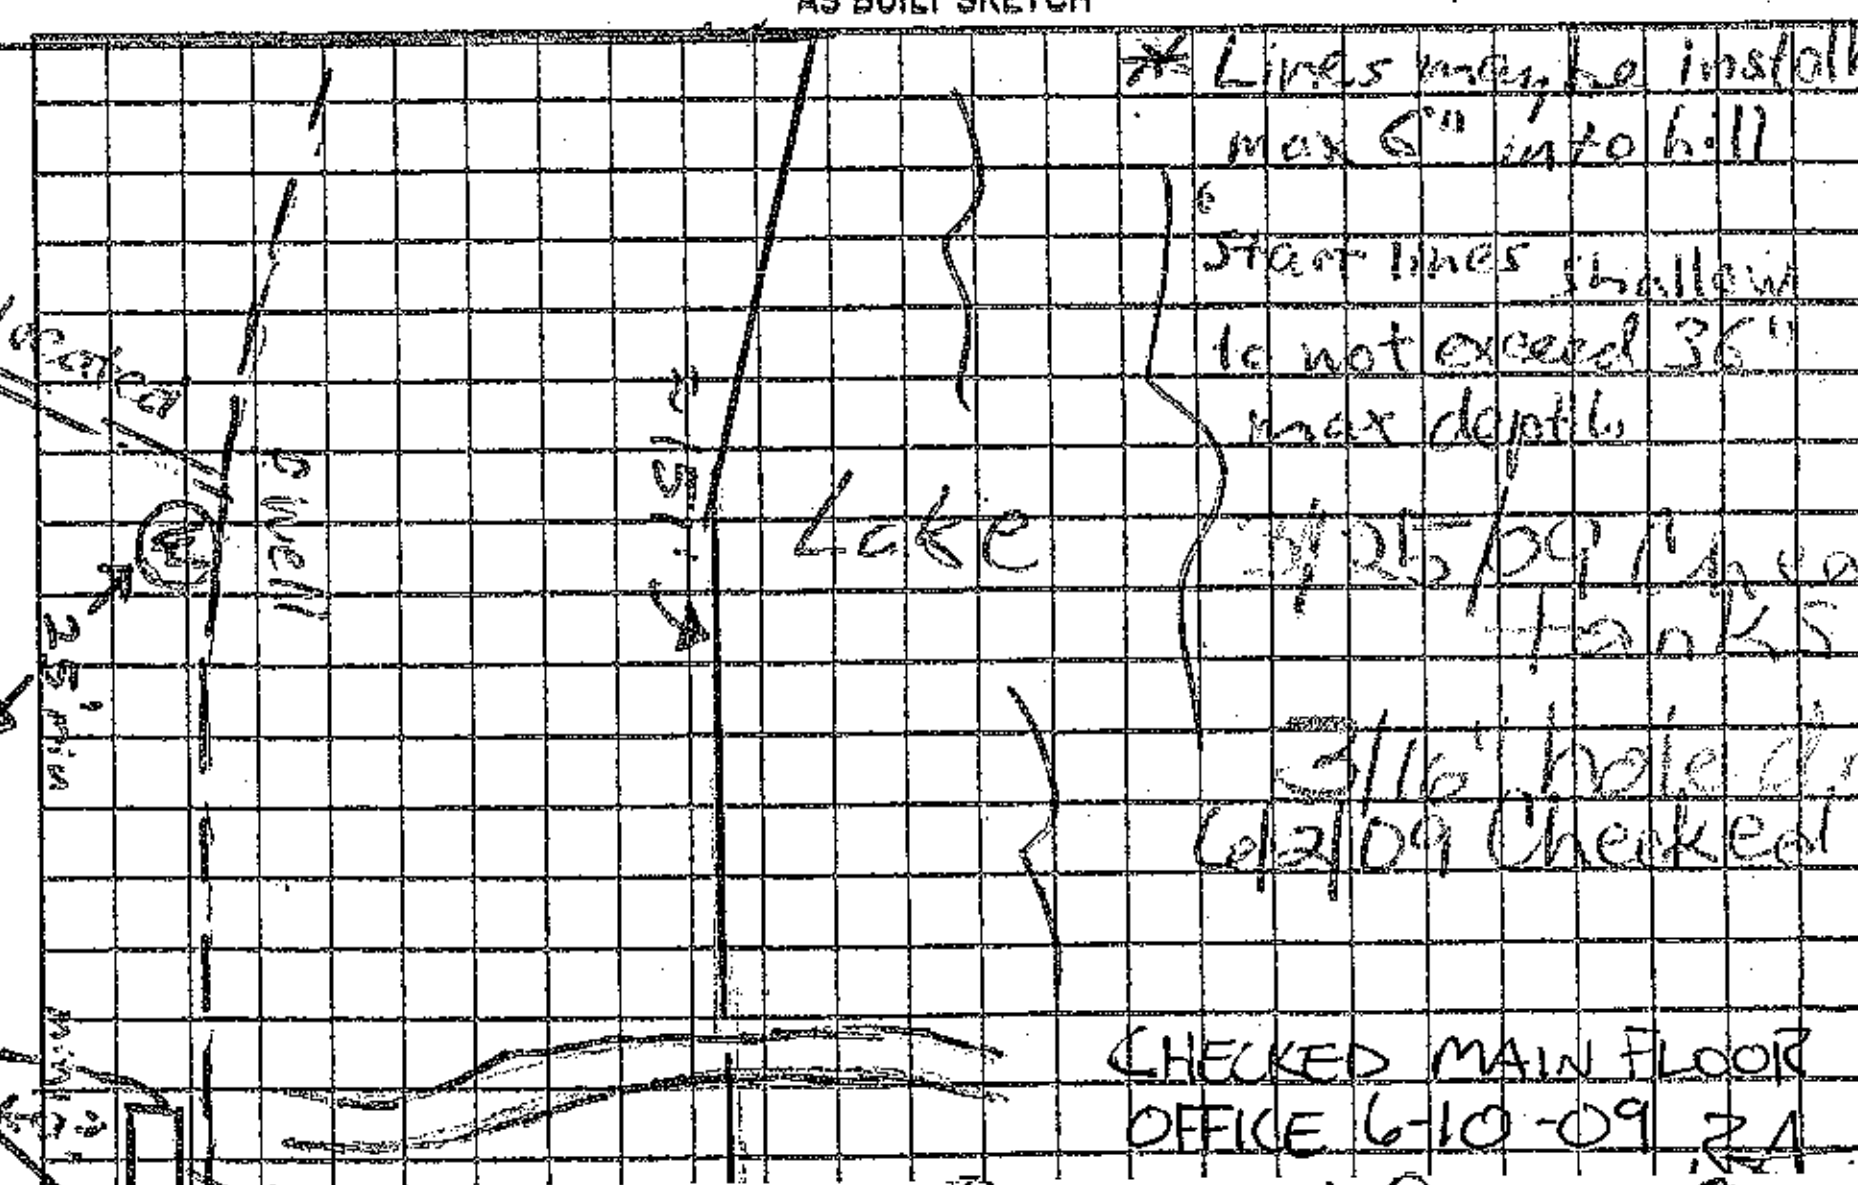

The proposed / existing Detached Garage addition does not appear to impact the existing septic system.
**NOTE:
[signature] Maria Dotson REHS
Date: 9/2/2010
ICHD-Environmental Health Division

Permit can be suspended or revoked if any false information is supplied toward securing the permit/any unauthorized changes are made t
Permit with plat valid without expiration ☐ Improvement Permit with site plan valid for sixty months ☑ Authorization to Cons

Signed: [signature] date 8/13/08
Improvement Permit by: Anthony Coker Jr. R.S. date 8/13/08
Authorization to Construct by: Anthony Coker Jr. R.S. date 8/13/08

Installed by: KRH
Operation Permit by: Maria H. Dotson RS date 6/11/09
Existing System Inspection by: date

HEALTH DEPT. COPY: WHITE OWNER COPY (FINAL): YELLOW OWNER COPY (INITIAL): PINK