As Built

IREDELL COUNTY HEALTH DEPARTMENT

STATESVILLE 704-878-5305 MOORESVILLE 704-664-5281

IMPROVEMENT PERMIT / AUTHORIZATION TO CONSTRUCT / OPERATION PERMIT / EXISTING SYSTEM INSPECTION

PERMIT # 147980 PIN # 4638070921 DATE 6-11-09

OWNER or APPLICANT Artisan Custom Homes PHONE: Business Home:

OWNER or APPLICANT ADDRESS

LOCATION / DIRECTIONS Perth Rd TL Fern Hill TR St. Charles Ln at end on left

SUBDIVISION C & T BLOCK / SECTION 15 LOT # 111 LOT AREA .81 Ac DESIGN FLOW 480 gpd L.T.A.R. .3

Septic Tank 1600 Gallons: STB 794 Date 1-19-09

Pump Tank 1000 Gallons: PT 283 Date 2-7-08

Pump Make Myers Model Serial #

Nitrification Field No Fields 1 No Lines 5 Linear Feet 270'

Trench Width 24" Max. Trench Bottom Depth 36" Gravel Depth N/A

☐ New System ☐ Repair ☐ Expansion System Type I II III IV V VI

System Description: LP PPBPS

Repair System Description: Same

Maintenance Agreement Required ☒ YES ☐ NO

☐ GRAVITY ☐ PRESSURE

☒ Residence No. Bedrooms 4

☐ Business No. Persons

☐ Other No. Employees

☐ Slab ☐ Crawl Space


☐ Basement w/plumbing ☐ Basement w/o plumbing

Water Supply: ☒ Private ☐ Public ☐ Community


Comments / Conditions

Comments / Conditions 3/16" hole drilled

INITIAL SITE SKETCH

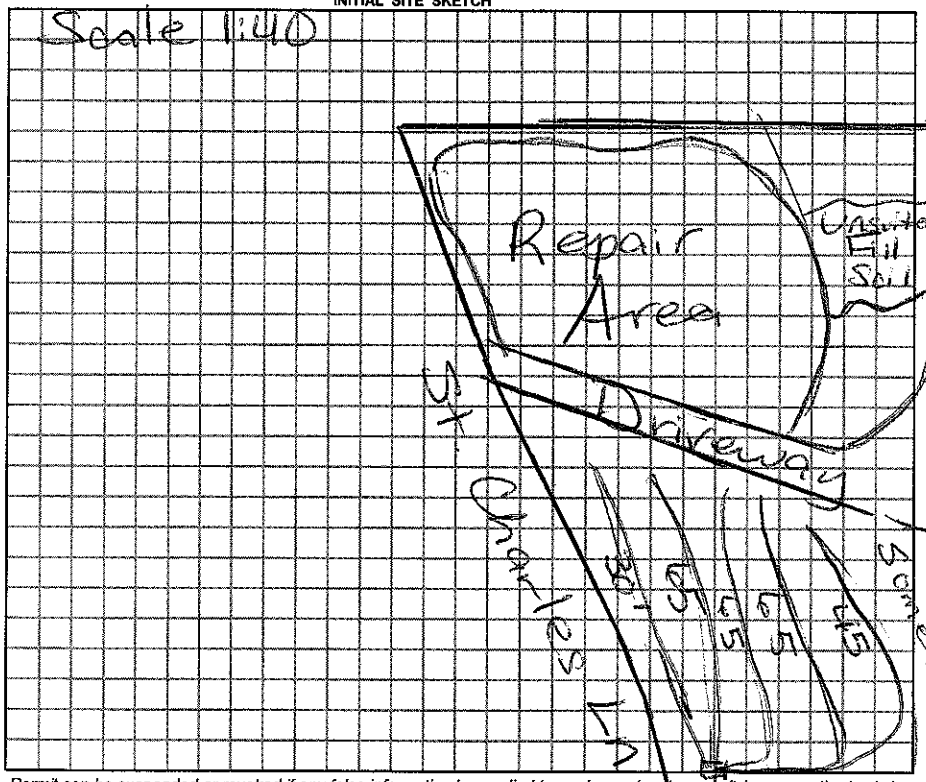

AS BUILT SKETCH

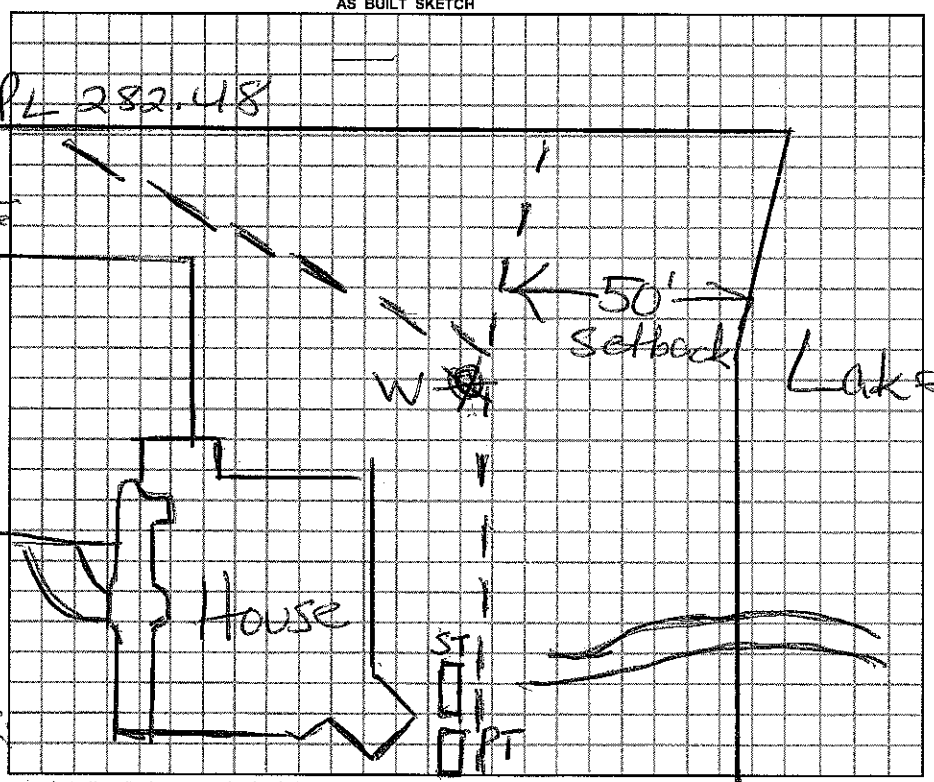

Permit can be suspended or revoked if any false information is supplied toward securing the permit / any unauthorized changes are made to the site / any unauthorized changes are made in the installation of the system.

☐ *IMPROVEMENT PERMIT w / plat valid without expiration.* ☐ *IMPROVEMENT PERMIT w / site plan valid for 60 mos.* ☐ *AUTHORIZATION TO CONSTRUCT valid for period equal to IMPROVEMENT PERMIT not to exceed 60 mo.*

Owner / Applicant Signature: Date

Improvement Permit by: Date

Authorzation to Construct by: Date

Installed by: R&H

Operation Permit by: Maria Dolson Date: 6/11/09

Existing System Inspected by: Date:

YOU SHOULD CONTACT A LOCATOR SERVICE PRIOR TO ANY EXCAVATION.

WHITE COPY Environmental Health YELLOW COPY (Final) Owner / Applicant PINK COPY (Initial) Owner / Applicant