IREDELL COUNTY HEALTH DEPARTMENT

Redraw owes 305.00

STATESVILLE 704-878-5305 MOORESVILLE 704-664-5281

11:30

IMPROVEMENT PERMIT / AUTHORIZATION TO CONSTRUCT / OPERATION PERMIT / EXISTING SYSTEM INSPECTION

PERMIT# 147980 PIN# 4638070921.000 DATE 8/13/08

OWNER OR APPLICANT Artisan Custom Homes PHONE: Business 704 987-9369 Home

ADDRESS PO Box 2218 Davidson NC 28036

LOCATION Ferth Rd. N TL Fern Hill Rd TR St Charles Ln at end on Lot

SUBDIVISION CLIFT BLOCK / SECTION 5 LOT 111 LOT AREA .81ac SITE CLASS. PS DESIGN FLOW 480 L.T.A.R. .3

Septic Tank: 1000 Gallons; STB 794 Date 1-19-09
Pump Tank: 1000 Gallons; P1 283 Date 2-1-08
Pump Mak Myers Model ME 50S2H No.
Nitrification Field; No. Fields 1 Square Feet 540 Linear Feet 270'
No. Lines 5 Trench Width 24" Max Trench Bottom Depth 36" Gravel Depth N/A

☑ New System ☐ Repair ☐ Expansion System Type: I II III (IV) V VI
System Description: LPP60S
Repair System Description: same
Maintenance Agreement Required: ☑ Yes ☐ No

☑ House/Mod. Home ☐ Mobile Home ☐ Business ☐ Other
No. Bedrooms 4 No. Persons No. Employees

Water Supply: ☑ Individual ☐ Public ☐ Community


☐ Gravity ☑ Pressure ☐ Slab ☐ Crawl Space ☑ Basement w/plumbing ☐ Basement wo/plumbing

Comments:/Conditions: * Maintain 25' min separation of Septic from cut of basement. * Exis drain to be relocated away from well area.
* See Attached S&ME plan


Comments:/Conditions: * Use Existing driveway, Build up/Fill Driveway to be even with ends of drainlines. Don't fill in drainfield Area.
* Fence off Septic areas during Construction
* Main Floor office must have cased doorway 6'8" O.P.

1:40

INITIAL SITE SKETCH

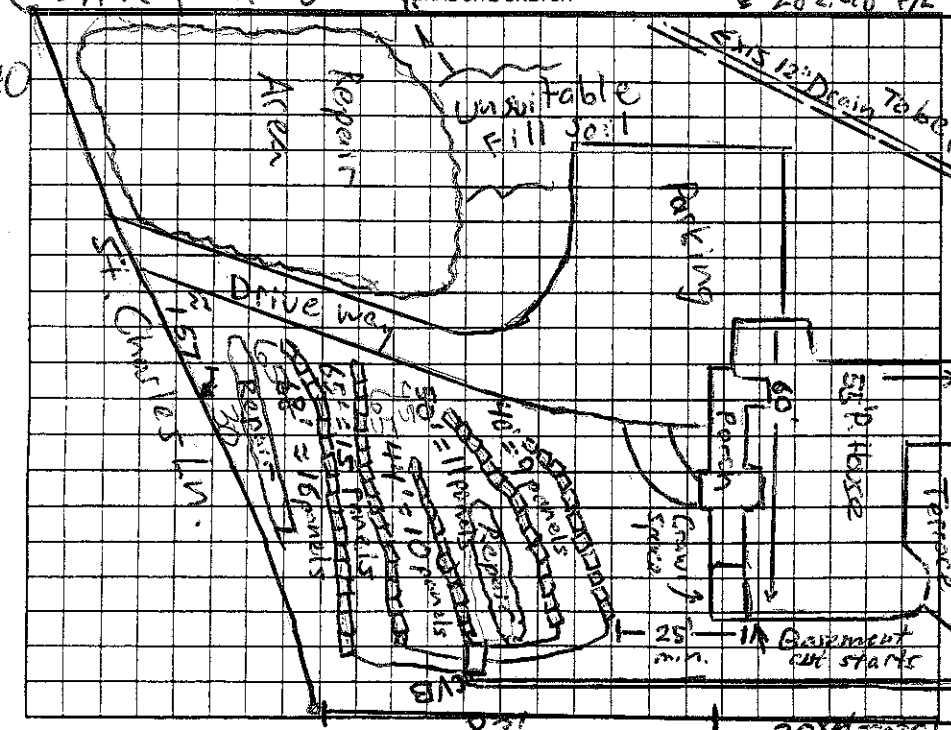

AS BUILT SKETCH

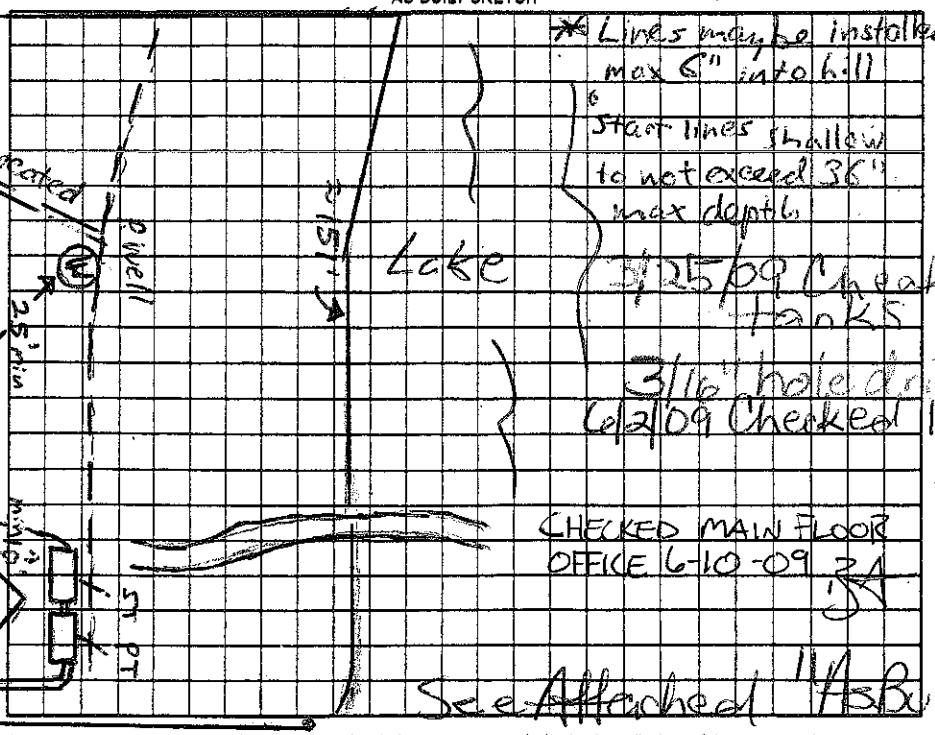

* Lines may be installed max 6" into b-11
* Start lines shallow to not exceed 36" max depth.

3/25/09 Checked Tanks

3/16" hole drilled 6/2/09 Checked lines

CHECKED MAIN FLOOR OFFICE 6-10-09 RA

See Attached "As Built"

Permit can be suspended or revoked if any false information is supplied toward securing the permit/any unauthorized changes are made to the site/any unauthorized changes are made in the installation of the system. Improvement Permit with plat valid without expiration ☐ Improvement Permit with site plan valid for sixty months ☑ Authorization to Construct is valid for a period equal to that of Improvement Permit – not to exceed sixty months.

Signed: [signature] date 8/13/08

Improvement Permit by: Anthony Coker Jr. R.S. date 8/13/08

Authorization to Construct by: Anthony Coker Jr. R.S. date 8/13/08

Installed by: date

Operation Permit by: [signature] R.S. date 6/11/09

Existing System Inspection by: date

HEALTH DEPT. COPY: WHITE OWNER COPY (FINAL): YELLOW OWNER COPY (INITIAL): PINK