IREDELL COUNTY HEALTH DEPARTMENT

STATESVILLE 704-878-5305 MOORESVILLE 704-664-5281

IMPROVEMENT PERMIT / AUTHORIZATION TO CONSTRUCT / OPERATION PERMIT / EXISTING SYSTEM INSPECTION

PERMIT# 08941 2 PIN# 4638071555 DATE 6/2/2000

OWNER OR CONTRACTOR Elizabeth Trester PHONE: Business Home 528-5639

ADDRESS 270 Fern Hill Rd Mooresville NC 28117

LOCATION Perth Rd TR Fern Hill on Rt before Split

SUBDIVISION C L & T (Duke) BLOCK / SECTION 15 LOT 107 LOT AREA .9 Acre SITE CLASS. DESIGN FLOW EXISTING GPD

Septic Tank: 1060 Existing Gallons; STB Date

Pump Tank: Gallons; PT Date

Pump Make: Model Serial No.

Nitrification Field: No Fields Square Feet Linear Feet

No Lines Trench Width Existing Max Trench Bottom Depth Gravel Depth

☐ New System ☐ Repair System Type: I, II, III, IV, V, VI

System Description: Existing Gravity-Conventional

Repair System Description:

Maintenance Agreement Required: ☐ Yes ☒ No

☒ House/Mod. Home No. Bedrooms 3

☐ Mobile Home No. Bathrooms 4

☐ Business No. Employees

☐ Other

☐ Slab ☐ Crawl Space ☒ Basement w/plumbing ☐ Basement wo/plumbing


Water Supply: ☒ Individual ☐ Public ☐ Community

Comments:/Conditions: Existing Septic System looked real good at time of inspection, no problems noticed.

*Not to Scale

Comments:/Conditions: Existing Septic tank was exposed for inspection approximately 6 feet below grade. May want to install Tank marker and/or riser on tank.

INITIAL SITE SKETCH

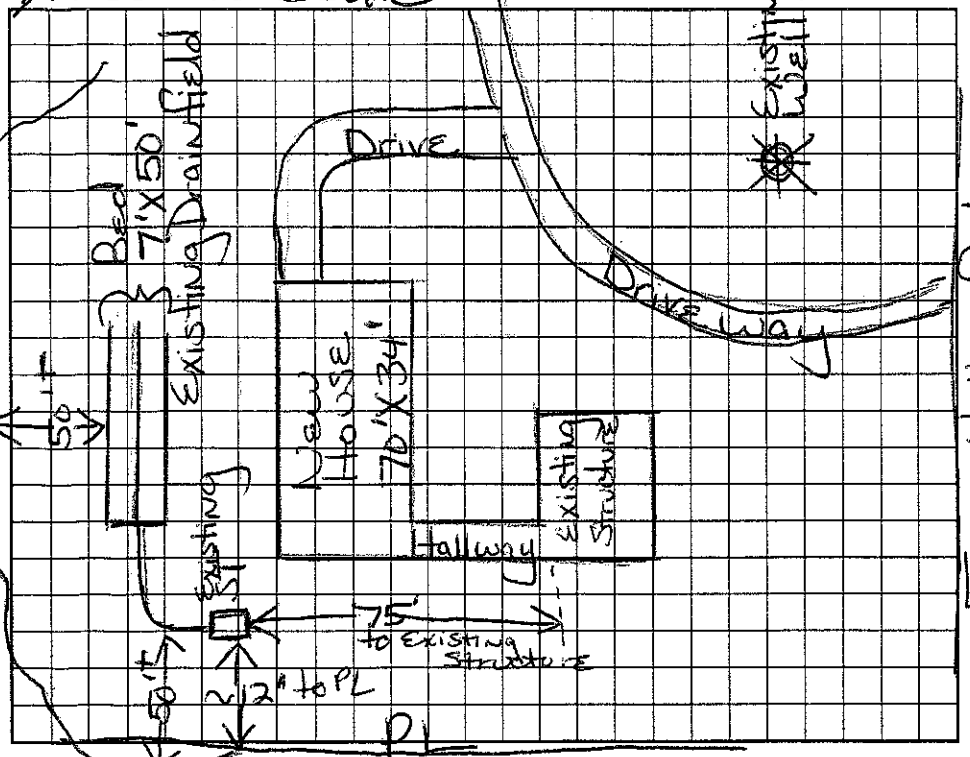

AS BUILT SKETCH

*Original System installed 1968, existing

done 1981

Permit can be suspended or revoked if any false information is supplied toward securing the permit/any unauthorized changes are made to the site/any unauthorized changes are made in the installation of the system. Improvement Permit with plat valid without expiration. Improvement Permit with site plan valid for sixty months. Authorization to Construct is valid for a period equal to that of Improvement Permit – not to exceed sixty months.

Signed: Elizabeth L. Trester date 6/2/00 Installed by:

Improvement Permit by: Maria H. Dotson RS date 6/2/2000 Operation Permit by: date

Authorization to Construct by: date Existing System Inspection by: Maria H. Dotson RS date 6/2/2000

HEALTH DEPT. COPY: WHITE OWNER COPY (FINAL): YELLOW OWNER COPY (INITIAL): PINK