IREDELL COUNTY HEALTH DEPARTMENT

Authorization to Construct

4638074254

STATESVILLE 704-878-5305 MOORESVILLE 704-664-5281

IMPROVEMENT PERMIT / ~~CERTIFICATE OF COMPLETION~~ / OPERATION PERMIT / EXISTING SYSTEM INSPECTION

PROPERTY DESCRIPTION NO. 22302 DATE 11/28/95 TAX MAP NO. 25 5 A 87 Watershed: [X] Yes [ ] No

OWNER OR CONTRACTOR Philip Shapiro PHONE: Business _____ Home 528-4525

ADDRESS 193 Broadview Lp. Mooresville, NC.

LOCATION Fem Hill toward Lake TL 2nd Broadview to first driveway on (R)

SUBDIVISION CL+T BLOCK / SECTION 15 LOT 87 LOT AREA ~1.74 SITE CLASS. _____ DESIGN FLOW 360 L.T.A.R. _____

Septic Tank: Existing Gallons; STB _____ Date _____

Pump Tank: _____ Gallons; PT _____ Date _____

Pump Make: _____ Model _____ Serial No. _____

Nitrification Field: No Fields ____ Square Feet _____ Linear Feet _____

No Lines _____ Trench Width _____ Max Trench Bottom Depth _____ Gravel Depth _____

[ ] New System [ ] Repair System Type: I, II, III, IV, V, VI

System Description: Existing System

Repair System Description: _____

Maintenance Agreement Required: [ ] Yes [ ] No

[X] House/Mod. Home No. Bedrooms 3

[ ] Mobile Home No. Bathrooms 2.5

[ ] Business No. Employees ____

[ ] Other _____

[ ] Slab [ ] Crawl Space [ ] Basement w/plumbing [ ] Basement wo/plumbing


Water Supply:
[X] Individual
[ ] Community
[ ] Public

Comments:

Broadview Loop

Comments:

INITIAL SITE SKETCH

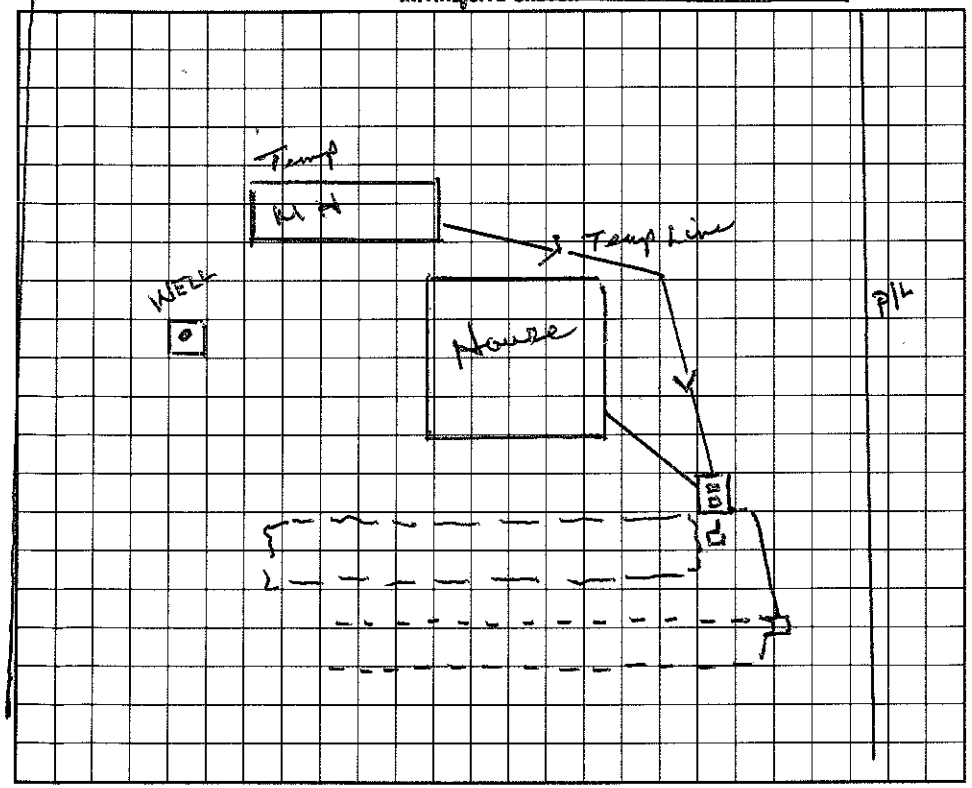

AS BUILT SKETCH

I understand that this permit can be suspended or revoked if any false information is supplied toward securing the permit/any unauthorized changes are made to the site/any unauthorized changes are made in the installation of the system.

Signed: _____

Improvement Permit by: Wesley Sparks R.S. date 11/28/95

~~Certificate of Completion by:~~ _____ date _____

~~Existing System Inspection by:~~ _____ date _____

Installed by: Existing System Wesley Sparks R.S. date 11/28/95

Operation Permit by: _____ date _____

Authorization to Construct! Wesley Sparks R.S.

HEALTH DEPT. COPY: WHITE INSPECTION COPY (FINAL): GREEN OWNER COPY (FINAL): YELLOW INSPECTION COPY (INITIAL): PINK OWNER COPY (INITIAL): GOLD