IREDELL COUNTY HEALTH DEPARTMENT

Authorization to Construct

STATESVILLE 704-878-5305 MOORESVILLE 704-664-5281

IMPROVEMENT PERMIT / ~~CERTIFICATE OF COMPLETION~~ / OPERATION PERMIT / EXISTING SYSTEM INSPECTION

PROPERTY DESCRIPTION NO. 23144 DATE 3/6/96 TAX MAP NO. 2 5 5A 86 4638075142 Watershed: [X] Yes [ ] No

OWNER OR CONTRACTOR R N Clendenin PHONE: Business _____ Home 528-3405

ADDRESS 187 Broadview Circle Mooresville, NC. 28115

LOCATION Fern Hill RD (R) off Perth Rd. TL 2nd Broadview Circle 3rd lot on (R)

SUBDIVISION C L + T BLOCK / SECTION 15 LOT 86 LOT AREA ~.84 AC SITE CLASS. PS DESIGN FLOW 360 L.T.A.R. .3

Septic Tank: 1000 Gallons; STB STB 1000 Date 2/24/97

Pump Tank: 1000 Gallons; PT 1219 Date _____

Pump Make: ZOELLER Model 267 Serial No. _____

Nitrification Field: No Fields 1 Square Feet 756 Linear Feet 252

No Lines 3 Trench Width 9' Max Trench Bottom Depth 36" Gravel Depth 12"

[ ] New System [X] Repair System Type: I, II, III, IV, V, VI

System Description: Add to original System

Repair System Description: _____

Maintenance Agreement Required: [ ] Yes [ ] No

[X] House/Mod. Home No. Bedrooms 3

[ ] Mobile Home No. Bathrooms 2.5

[ ] Business No. Employees _____

[ ] Other _____

[ ] Slab [ ] Crawl Space [X] Basement w/plumbing [ ] Basement wo/plumbing


Water Supply: [X] Individual [ ] Community [ ] Public

Comments: Adding to original system to support proposed 3 bedroom house


Comments: Need to have well Pump Tank - and make electrical connection

Basement Bottom slope

INITIAL SITE SKETCH

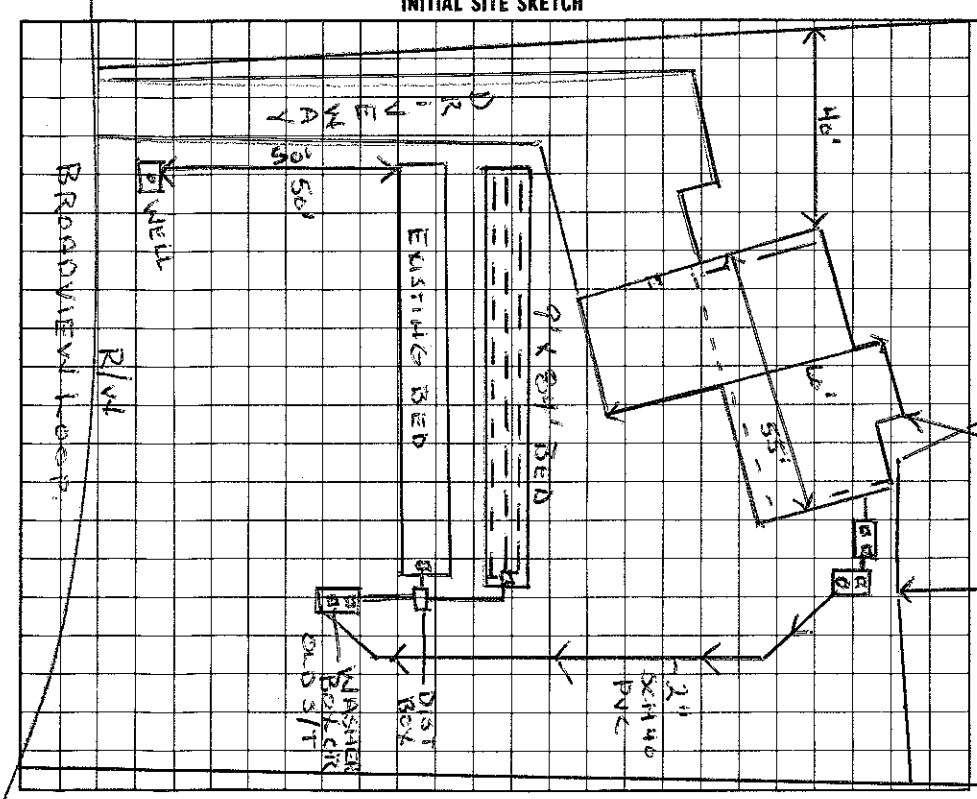

AS BUILT SKETCH

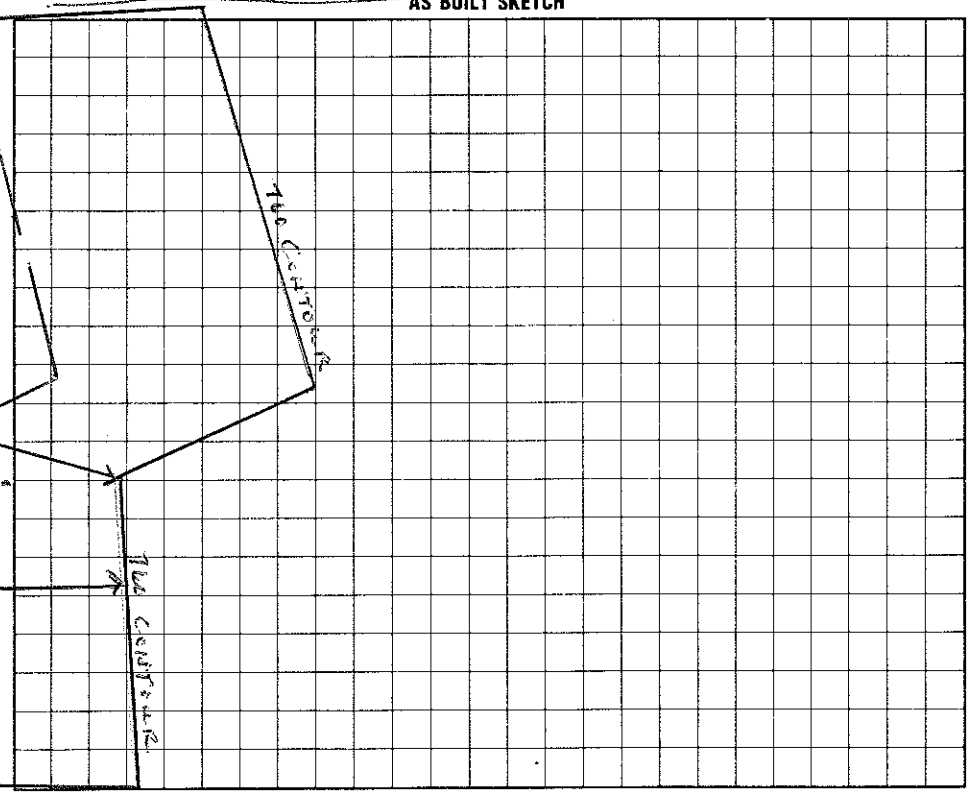

I understand that this permit can be suspended or revoked if any false information is supplied toward securing the permit/any unauthorized changes are made to the site/any unauthorized changes are made in the installation of the system.

Signed: X R. N. Clendenin 3-14-96

Improvement Permit by: Wesley Sparks R.S. date 3/6/96

Authorization to Construct Existing System Inspection by: Wesley Sparks R.S. date 3/6/96

Installed by: Kenny Pearson

Certificate of Completion by: Wesley Sparks R.S. date 3/8/97

Operation Permit by: Wesley Sparks RS date 3/8/97

HEALTH DEPT. COPY: WHITE INSPECTION COPY (FINAL): GREEN OWNER COPY (FINAL): YELLOW INSPECTION COPY (INITIAL): PINK OWNER COPY (INITIAL): GOLD