IREDELL COUNTY HEALTH DEPARTMENT

STATESVILLE 704-878-5305 MOORESVILLE 704-664-5281

IMPROVEMENT PERMIT / AUTHORIZATION TO CONSTRUCT / OPERATION PERMIT / EXISTING SYSTEM INSPECTION

PERMIT# 072877 PIN# 4438 07 7315 DATE 1/3/00

OWNER OR CONTRACTOR Michael Berry PHONE: Business 528-0061 Home

ADDRESS 154 Lee Dr. Troutman, NC. 28166

LOCATION North N TL Fern Hill Rd. TL 2ND Broadview 2ND lot on (L)

SUBDIVISION BROADVIEW BLOCK / SECTION LOT 11 LOT AREA .97AC SITE CLASS. PS DESIGN FLOW 480 L.T.A.R. .3

Septic Tank: 1000 Gallons; STB 1007 Date 6/6/01
Pump Tank: Gallons; PT Date
Pump Make: Model Serial No.
Nitrification Field: No Fields 1 Square Feet 1200 Linear Feet 400
No Lines 5@80' Trench Width 3' Max Trench Bottom Depth 30" Gravel Depth SAND

☒ New System ☐ Repair System Type: I, II, (III) IV, V, VI
System Description: Gravity -25% reduced
Repair System Description: Same
Maintenance Agreement Required: ☐ Yes ☒ No

☒ House/Mod. Home No. Bedrooms 4
☐ Mobile Home No. Bathrooms 2.5
☐ Business No. Employees
☐ Other
☐ Slab ☐ Crawl Space ☐ Basement w/plumbing ☐ Basement wo/plumbing


Water Supply: ☒ Individual ☐ Public ☐ Community

Comments:/Conditions:


Comments:/Conditions:

(1" = 50')

INITIAL SITE SKETCH

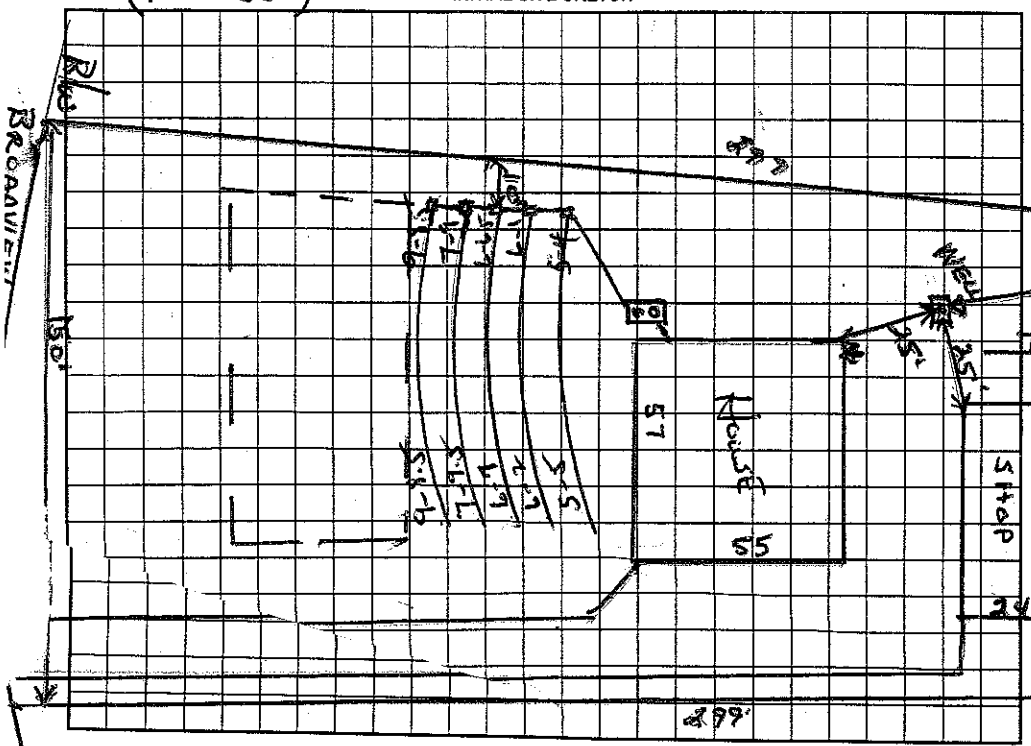

AS BUILT SKETCH

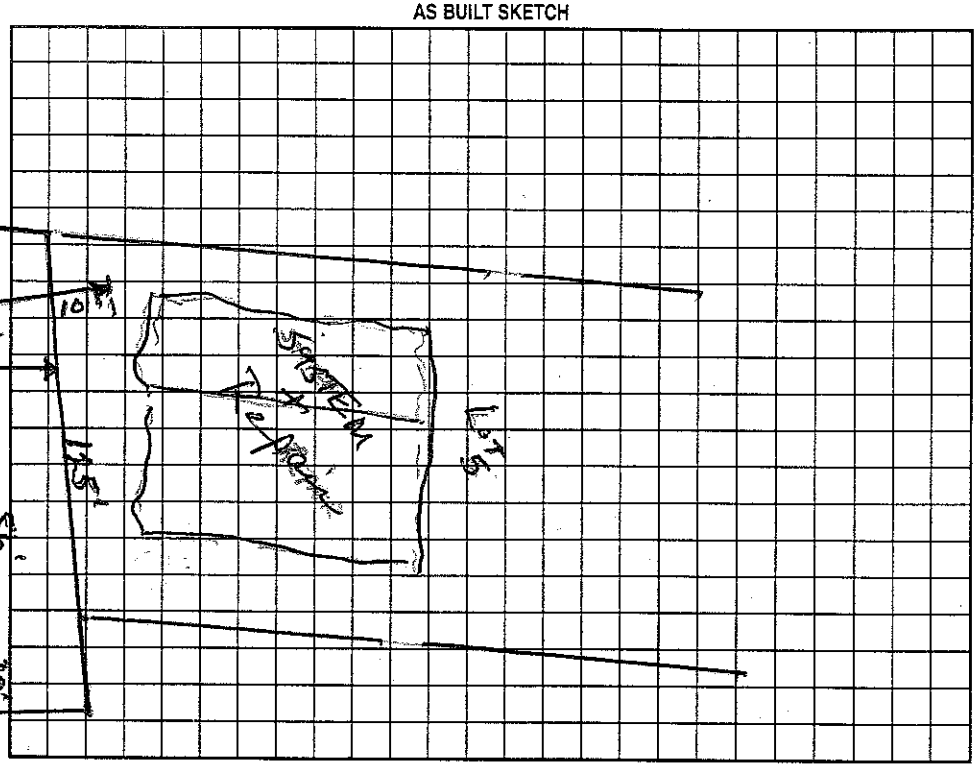

Permit can be suspended or revoked if any false information is supplied toward securing the permit/any unauthorized changes are made to the site/any unauthorized changes are made in the installation of the system. Improvement Permit with plat valid without expiration. Improvement Permit with site plan valid for sixty months. Authorization to Construct is valid for a period equal to that of Improvement Permit – not to exceed sixty months.

Signed: * Michael Berry date

Improvement Permit by: Wesley Sparks R.S. date 1/3/01

Authorization to Construct by: Wesley Sparks R.S. date 1/3/01

Installed by: Wayne Clontz

Operation Permit by: Wesley Sparks R.S. date 7/31/01

Existing System Inspection by: date

HEALTH DEPT. COPY: WHITE OWNER COPY (FINAL): YELLOW OWNER COPY (INITIAL): PINK