2-3

# IREDELL COUNTY HEALTH DEPARTMENT

STATESVILLE 704-878-5305 MOORESVILLE 704-664-5281

## IMPROVEMENT PERMIT / AUTHORIZATION TO CONSTRUCT / OPERATION PERMIT / EXISTING SYSTEM INSPECTION

PERMIT# 070734 PIN# 4639402347 DATE 1/27/98

OWNER OR CONTRACTOR James & Beaky Griffin PHONE: Business (704) 888-2271 Beaky Home (704) 545-5766

ADDRESS PO Box 23027 Charlotte, NC 28212 / 6000 Robin Hollow Dr. Charlotte, NC 28227

LOCATION Penth Rd N. TL Fern Hill TL Kenway Loop on Left at Ogden

SUBDIVISION Lot 5 Sec 5 BLOCK / SECTION 15 LOT 12 LOT AREA ____ SITE CLASS. P.S DESIGN FLOW 360 gpd L.T.A.R. .3

Septic Tank: 1000 Gallons; STB 794 Date 11/23/98

Pump Tank: ____ Gallons; PT ____ Date 11-3-98

Pump Make: ____ Model ____ Serial No. ____

Nitrification Field: No Fields 1 Square Feet *900' Linear Feet *300'

No Lines 3 at 100' Trench Width 36" Max Trench Bottom Depth 36" Gravel Depth N/A

☒ New System ☐ Repair System Type: I, II, III, IV, V, VI

System Description: Gravel Pl. Chamber or Similar

Repair System Description: Pump - Modified

Maintenance Agreement Required: ☐ Yes ☒ No

☒ House/Mod. Home No. Bedrooms 3

☐ Mobile Home No. Bathrooms 3

☐ Business No. Employees ____

☐ Other ____


☐ Slab ☐ Crawl Space ☐ Basement w/plumbing ☒ Basement wo/plumbing

Water Supply: ☒ Individual ☐ Public ☐ Community


Comments:/Conditions: Keep Septic System at least 15' From Side of House, 10' from Property lines & 50' From 760° Contour of Lake. *25% Reduction in Drainfield Area

Comments:/Conditions: *New Construction will be over Existing Septic System therefore Old Septic System must be abandoned. 1st line 94' line 2 & 3 - 100'

INITIAL SITE SKETCH Not to Scale

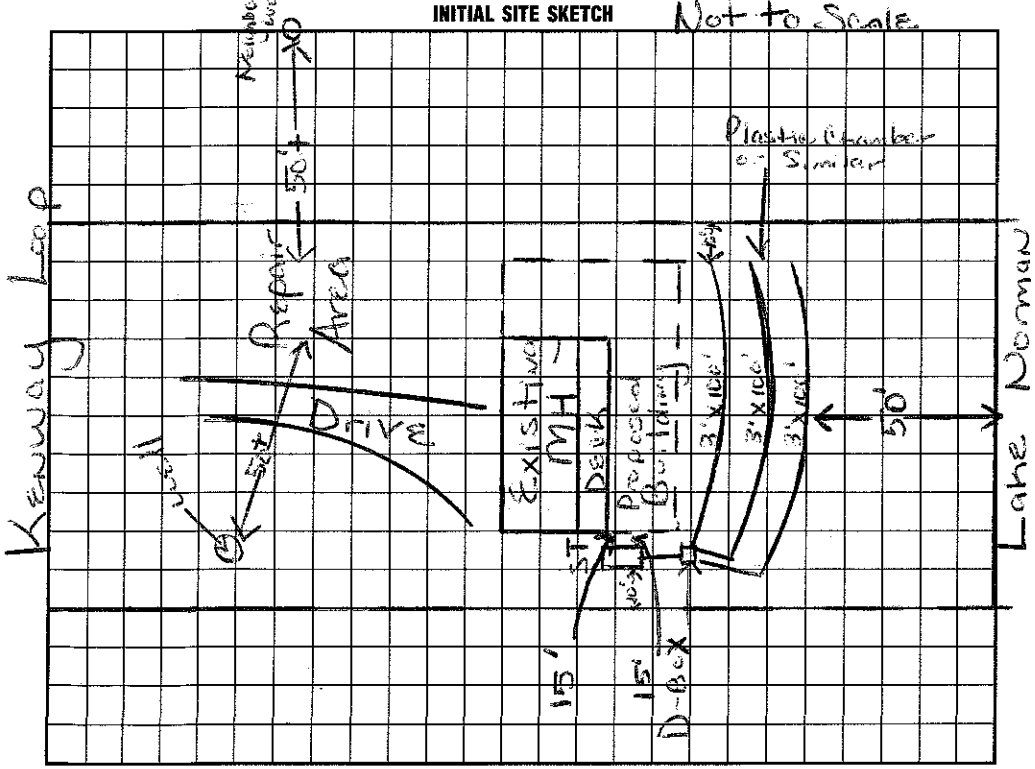


AS BUILT SKETCH

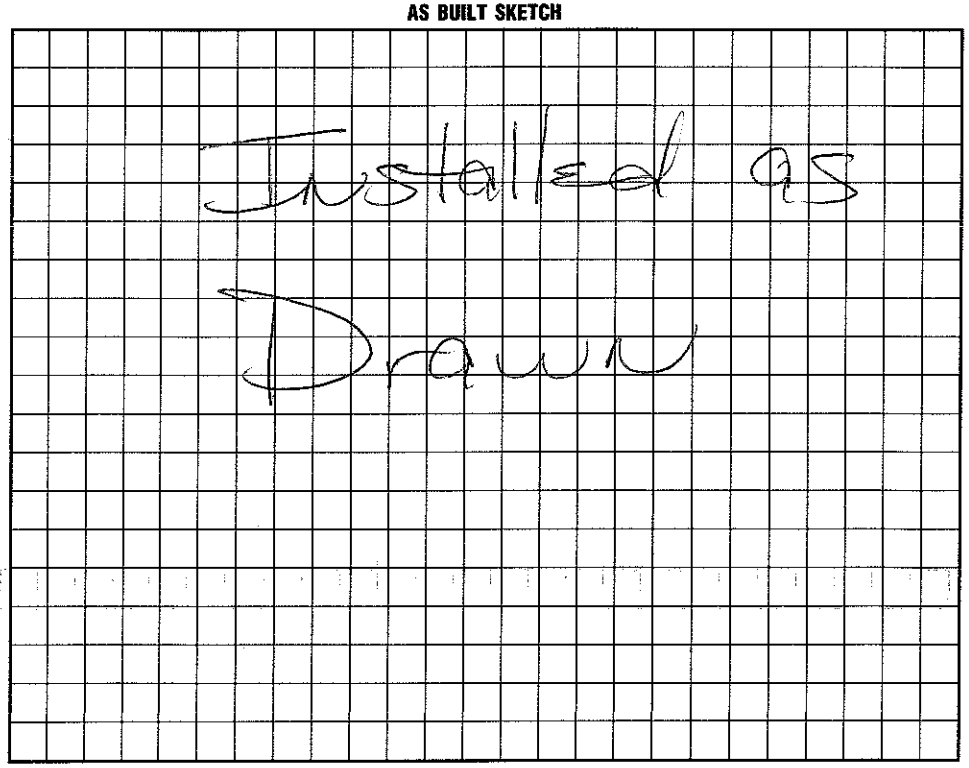


I understand that this permit can be suspended or revoked if any false information is supplied toward securing the permit/any unauthorized changes are made to the site/any unauthorized changes are made in the installation of the system. Improvement Permit with plat valid without expiration. Improvement Permit with site plan valid for sixty months. Authorization to Construct is valid for a period equal to that of Improvement Permit – not to exceed sixty months.

Signed: Rebecca J. Gregor date 2-2-98

Improvement Permit by: Maria H. Dotson date 1/27/98

Authorization to Construct by: Maria H. Dotson date 1/27/98

Installed by: James Hudler

Operation Permit by: Maria H. Dotson RS date 1/27/99

Existing System Inspection by: ____ date ____

HEALTH DEPT. COPY: WHITE INSPECTION COPY (FINAL): GREEN OWNER COPY (FINAL): YELLOW INSPECTION COPY (INITIAL): PINK OWNER COPY (INITIAL): GOLD