IREDELL COUNTY HEALTH DEPARTMENT

STATESVILLE 704-878-5305 4638 09 6228 MOORESVILLE 704-664-5281

IMPROVEMENT PERMIT / CERTIFICATE OF COMPLETION / OPERATION PERMIT / EXISTING SYSTEM INSPECTION

PROPERTY DESCRIPTION NO. 17492 DATE 2/24/94 TAX MAP NO. 3L-1D-A-129 Watershed: ☐ Yes ☒ No

OWNER OR CONTRACTOR FRANK N. FARRELL JR. PHONE: Business _____ Home 910-718-5879

ADDRESS 129 HEATHERTON WAY WINSTON SALEM, NC. 158 Bridlewood Drive

LOCATION BRIDLEWOOD DR. - FERN HILL TOWARD LAKE TR BRIDLEWOOD, (L) FORK, BEAR (R) DOWN HILL TOWARD WATER

SUBDIVISION CL+T BLOCK / SECTION 15 LOT 129 LOT AREA EXISTING SITE CLASS. P DESIGN FLOW 360 L.T.A.R. .25-.3

Septic Tank: 1000 Gallons; STB 725 RST Date 6-11-94

Pump Tank: 1000 Gallons; PT 49 RST Date 7-20-94

Pump Make: _____ Model _____ Serial No. _____

Nitrification Field: No Fields 1 Square Feet 1200 Linear Feet 240 x

No Lines 4 Trench Width 2' Max Trench Bottom Depth 36" Gravel Depth 6" SAND

☒ New System ☐ Repair System Type: I, II, III, (IV), V, VI

System Description: PRESSURE - PANEL BLOCK

Repair System Description: SAME

Maintenance Agreement Required: ☒ Yes ☐ No

☒ House/Mod. Home No. Bedrooms 3

☐ Mobile Home No. Bathrooms 2

☐ Business No. Employees ____


☐ Other _____

☐ Slab ☒ Crawl Space ☐ Basement w/plumbing ☐ Basement wo/plumbing

Water Supply: ☒ Individual ☐ Community ☐ Public

Comments: SEE ATTACHED — 760

INITIAL SITE SKETCH

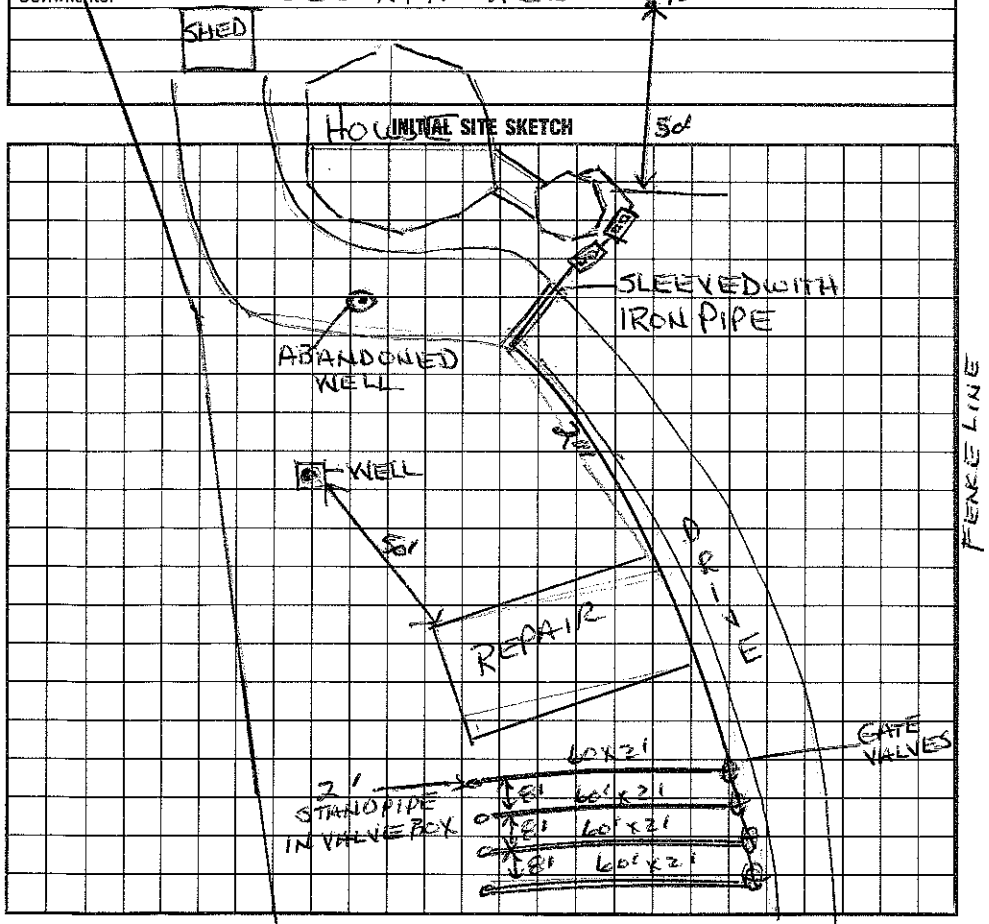

Comments:

AS BUILT SKETCH

Substantially as shown

I understand that this permit can be suspended or revoked if any false information is supplied toward securing the permit/any unauthorized changes are made to the site/any unauthorized changes are made in the installation of the system. Improvement Permit is valid for 60 months from date of issuance.

Signed: Brian Farrell

Improvement Permit by: Wesley Sparks R.S. date 2/24/93

Existing System Inspection by: _____ date _____

Installed by: Rowan Septic Tank

Certificate of Completion by: Wesley Sparks R.S. date 12/29/94

Operation Permit by: Wesley Sparks R.S. date 12/29/94

HEALTH DEPT. COPY: WHITE INSPECTION COPY (FINAL): GREEN OWNER COPY (FINAL): YELLOW INSPECTION COPY (INITIAL): PINK OWNER COPY (INITIAL): GOLD