IREDELL COUNTY HEALTH DEPARTMENT

STATESVILLE 704-878-5305 MOORESVILLE 704-664-5281

IMPROVEMENT PERMIT / AUTHORIZATION TO CONSTRUCT / OPERATION PERMIT / EXISTING SYSTEM INSPECTION

PERMIT# 103013 PIN# 4638097398 Chuck Cranfill DATE 10-31-01

OWNER OR CONTRACTOR Jim Zilisch PHONE: Business 309-2707 Home

ADDRESS 9400 Hampton Oaks Ln, Charlotte, NC 28270

LOCATION Fern Hill Rd TR Bridlewood at corner of Cullenwood (at fork) 136 Bridlewood

SUBDIVISION BLOCK / SECTION LOT LOT AREA SITE CLASS. PS DESIGN FLOW 240gpd L.T.A.R. ± 3

Septic Tank: Existing Gallons: STB Date

Pump Tank: Gallons: PT Date

Pump Make: Model Serial No.

Nitrification Field: No Fields Square Feet Linear Feet

No Lines Trench Width Existing Max Trench Bottom Depth Gravel Depth

☐ New System ☐ Repair System Type: I, II, III, IV, V, VI

System Description: Gravity Conv.

Repair System Description:

Maintenance Agreement Required: ☐ Yes ☒ No

☐ House/Mod. Home No. Bedrooms 1

☐ Mobile Home No. Bathrooms 1

☐ Business No. Employees


☒ Other Garage w/Upstairs Bedroom

☒ Slab ☐ Crawl Space ☐ Basement w/plumbing ☐ Basement w/o plumbing

Water Supply: ☒ Individual ☐ Public ☐ Community


Comments:/Conditions: Set back to lake

INITIAL SITE SKETCH

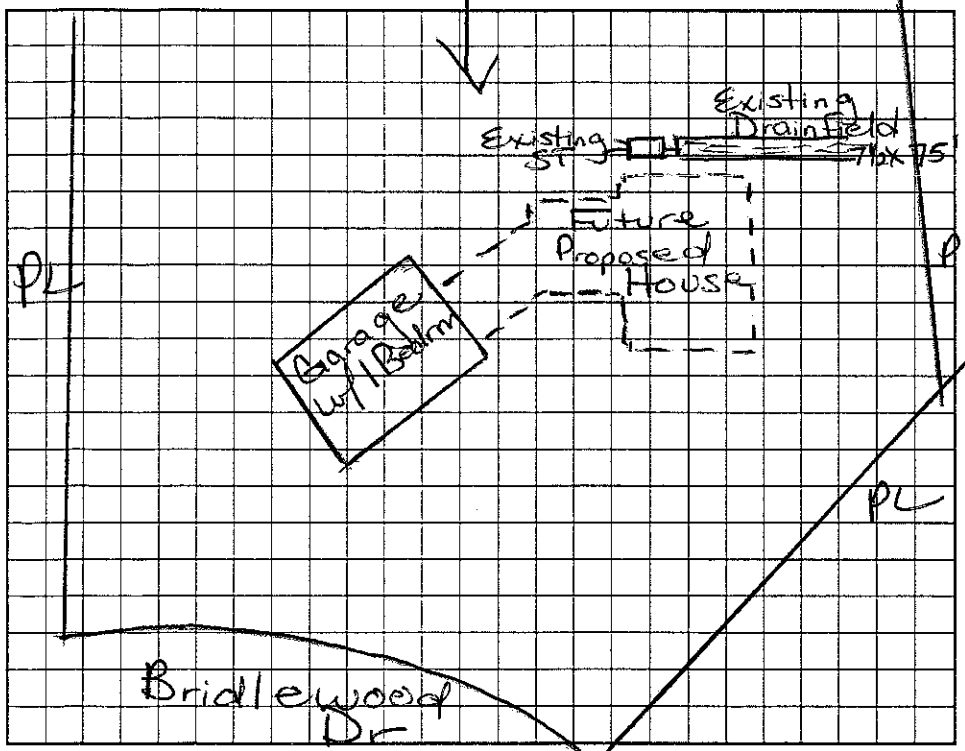

Comments:/Conditions: Existing Septic System appears to be functioning okay at time of inspection. Okay to use for Garage with 1-2 Bedrooms.

AS BUILT SKETCH

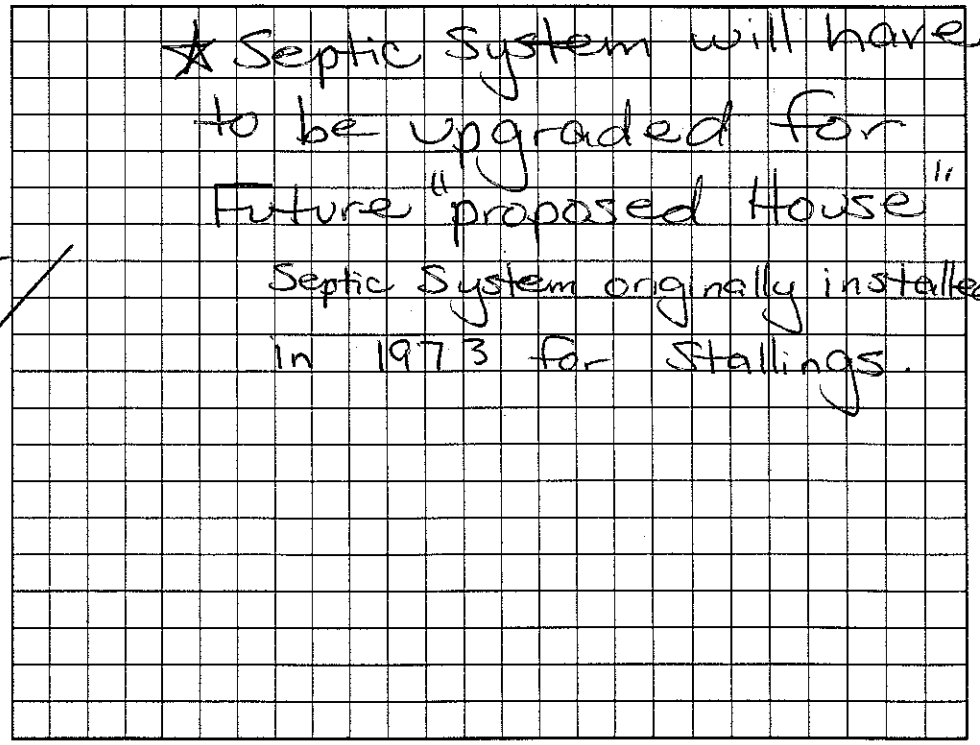

Permit can be suspended or revoked if any false information is supplied toward securing the permit/any unauthorized changes are made to the site/any unauthorized changes are made in the installation of the system. Improvement Permit with plat valid without expiration. Improvement Permit with site plan valid for sixty months. Authorization to Construct is valid for a period equal to that of Improvement Permit – not to exceed sixty months.

Signed: date 10/31/2001 Installed by:

Improvement Permit by: Maria H. Dotson RS date 10/31/2001 Operation Permit by: date

Authorization to Construct by: date Existing System Inspection by: Maria H. Dotson RS date 10/31/2001

HEALTH DEPT. COPY: WHITE OWNER COPY (FINAL): YELLOW OWNER COPY (INITIAL): PINK