IREDELL COUNTY HEALTH DEPARTMENT

Statesville Phone TR 3-7271 Mooresville Phone No. 664-5281

PERMIT TO INSTALL SEPTIC TANK

Permit No. 69 Permit Date 5-3- 1973

Owner Stallings Address Troutman

Installed By Sam oswalt Address Troutman


Location of Property Fern Hill church Rt Go to Rt 1398 and turn ~~left~~ right directly across from 1398 Kenway Go 1/4 Trailor on right

Tank		Capacity		Length of Lines		Fixtures	
Block	( )	1000	(✓)	225'	(✓)	No. of Baths	(2)
Precast	(✓)	1250	( )	250'	( )	Dishwasher	(No)
		1500	( )	Other		Garbage Grdr.	(No)
		Other				Other Washing machine	

NOTIFY HEALTH DEPARTMENT AT LEAST EIGHT HOURS BEFORE TANK IS TO BE INSPECTED.

Final Inspection 5- 3- 1973 Approved (✓) Disapprcved ( )

Remarks

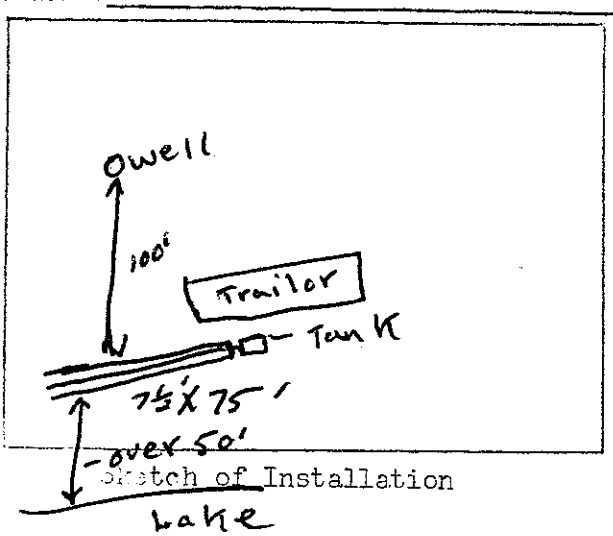

Sketch of Installation

J. C. Moore
Sanitarian