IREDELL COUNTY HEALTH DEPARTMENT

STATESVILLE 704-878-5305 130.00 Pd. MOORESVILLE 704-664-5281

IMPROVEMENT PERMIT / AUTHORIZATION TO CONSTRUCT / OPERATION PERMIT / EXISTING SYSTEM INSPECTION

PERMIT# 117437 PIN# 4638 11 4476 DATE 2/11/04

OWNER OR CONTRACTOR JSKI, LLC PHONE: Business 704-713-0592 Home

ADDRESS PO Box 237 Cornelius, NC. 28031

LOCATION 150 W TR Robinson RD TL Rustic Way Ln. to culde sac, lot directly off culde sac

SUBDIVISION EAST LAKE BLOCK / SECTION LOT 8 LOT AREA 21,780 Ft² SITE CLASS. PS DESIGN FLOW 360 L.T.A.R. .3

Septic Tank: 1000 Gallons; STB 317 Date 8/13/04
Pump Tank: Gallons; PT Date
Pump Make: Model Serial No.
Nitrification Field: No Fields 1 Square Feet 900 Linear Feet 300
No Lines 4 @ 75' Trench Width 3' Max Trench Bottom Depth 3' Gravel Depth N/A

☒ New System ☐ Repair System Type: I, II, (III), IV, V, VI
System Description: GRAVITY - Type 3
Repair System Description: Same
Maintenance Agreement Required: ☐ Yes ☒ No

☒ House/Mod. Home No. Bedrooms 3
☐ Mobile Home No. Bathrooms 2
☐ Business No. Employees
☐ Other
☐ Slab ☒ Crawl Space ☒ Basement w/plumbing ☐ Basement wo/plumbing


Water Supply:
☒ Individual
☐ Public
☐ Community

Comments:/Conditions:
2nd House plan + site plan required for AC.


Comments:/Conditions:

(1" = 30')

INITIAL SITE SKETCH

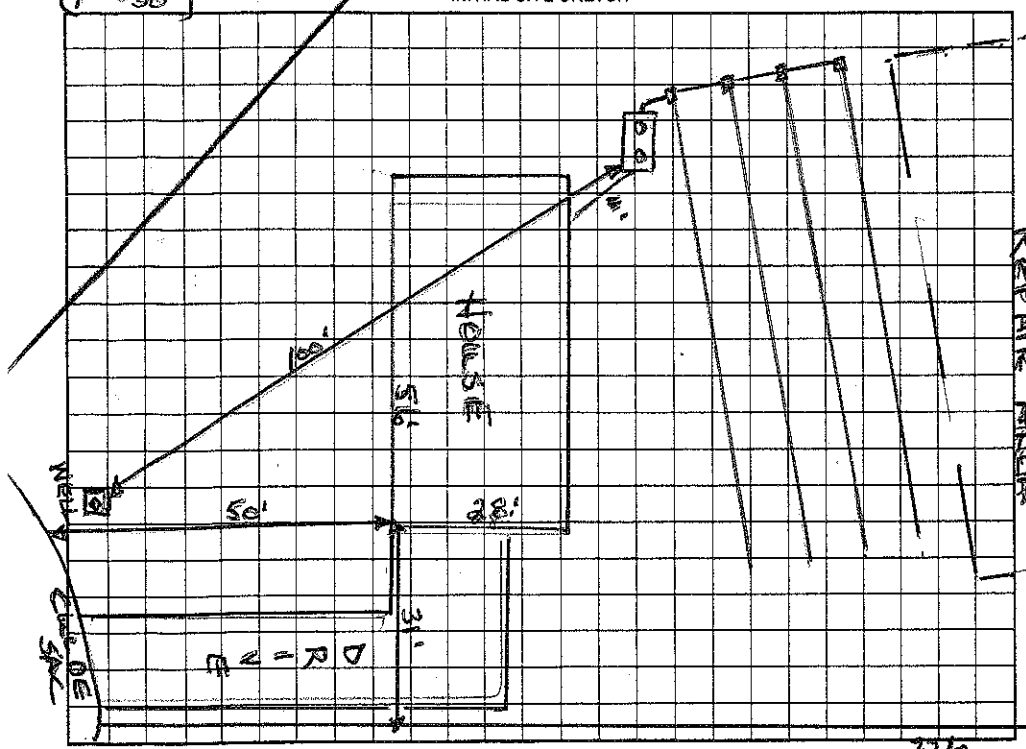

AS BUILT SKETCH

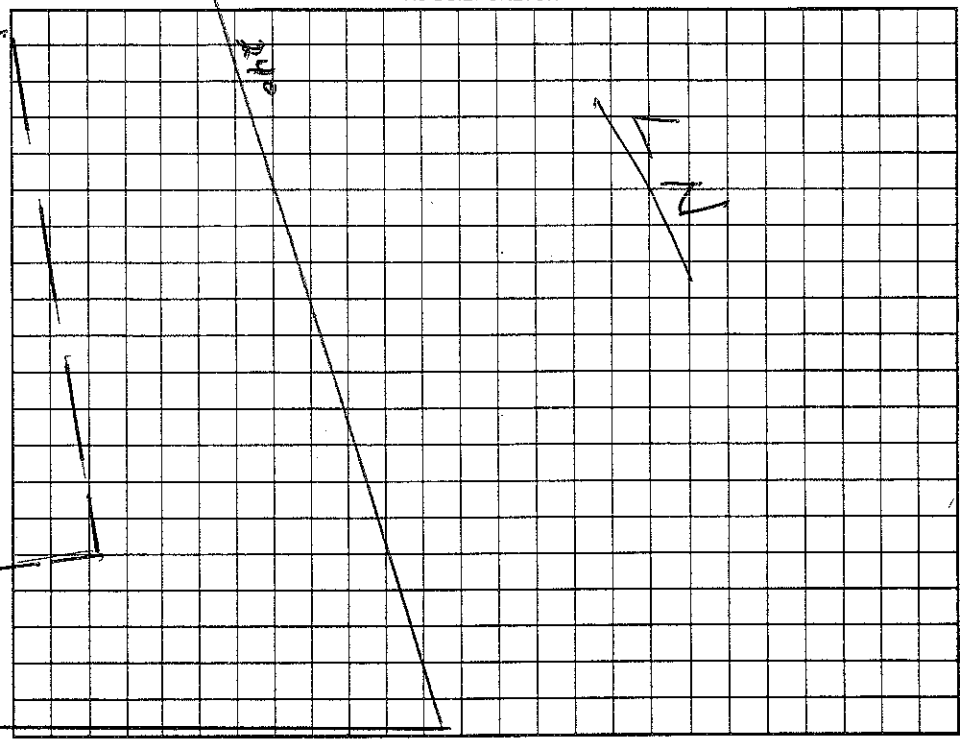

Permit can be suspended or revoked if any false information is supplied toward securing the permit/any unauthorized changes are made to the site/any unauthorized changes are made in the installation of the system. Improvement Permit with plat valid without expiration. Improvement Permit with site plan valid for sixty months. Authorization to Construct is valid for a period equal to that of Improvement Permit – not to exceed sixty months.

Signed: * date 2-17-04

Improvement Permit by: Wesley Sparks RS. date 2/11/04

Authorization to Construct by: Wesley Sparks RS date 4/27/04

Installed by: Marty Tucker

Operation Permit by: Wesley Sparks RS. date 7/13/04

Existing System Inspection by: date

HEALTH DEPT. COPY: WHITE OWNER COPY (FINAL): YELLOW OWNER COPY (INITIAL): PINK