IREDELL COUNTY HEALTH DEPARTMENT

STATESVILLE 704-878-5305 130.00 Paid MOORESVILLE 704-664-5281

IMPROVEMENT PERMIT / AUTHORIZATION TO CONSTRUCT / OPERATION PERMIT / EXISTING SYSTEM INSPECTION

PERMIT# 117442 PIN# 4638 11 5398 DATE 2/11/04

OWNER OR CONTRACTOR ISKI, LLC PHONE: Business 704-713-0592 Home

ADDRESS PO Box 237 Cornelius, NC 28031

LOCATION 150W TR Robinson Rd. TL Rustic Way Ln. to cul de sac, on (L)

SUBDIVISION East Lake BLOCK / SECTION LOT 9 LOT AREA 21,780 SITE CLASS. PS DESIGN FLOW 240 L.T.A.R. .3

Septic Tank: 1000 Gallons; STB 794 Date 12/31/04
Pump Tank: Gallons; PT Date
Pump Make: Model Serial No.
Nitrification Field: No Fields 1 Square Feet 600 Linear Feet 200
No Lines 4 @ 50' Trench Width 2-3' Max Trench Bottom Depth 3' Gravel Depth N/A

[X] New System ☐ Repair System Type: I, II, (III), IV, V, VI
System Description: GRAVITY - 16" PPBPS
Repair System Description: SAME
Maintenance Agreement Required: ☐ Yes [X] No
☐ Slab [X] Crawl Space ☐ Basement w/plumbing ☐ Basement wo/plumbing

[X] House/Mod. Home No. Bedrooms 2
☐ Mobile Home No. Bathrooms 2
☐ Business No. Employees
☐ Other


Water Supply:
☐ Individual
☐ Public
☐ Community

Comments:/Conditions: House plan + site plan required for AC. Foundation to be stepped up to facilitate daylighted room on lowest level with no plumbing. - AWS (1" = 30')

Comments:/Conditions: Installed as drawn

INITIAL SITE SKETCH

AS BUILT SKETCH

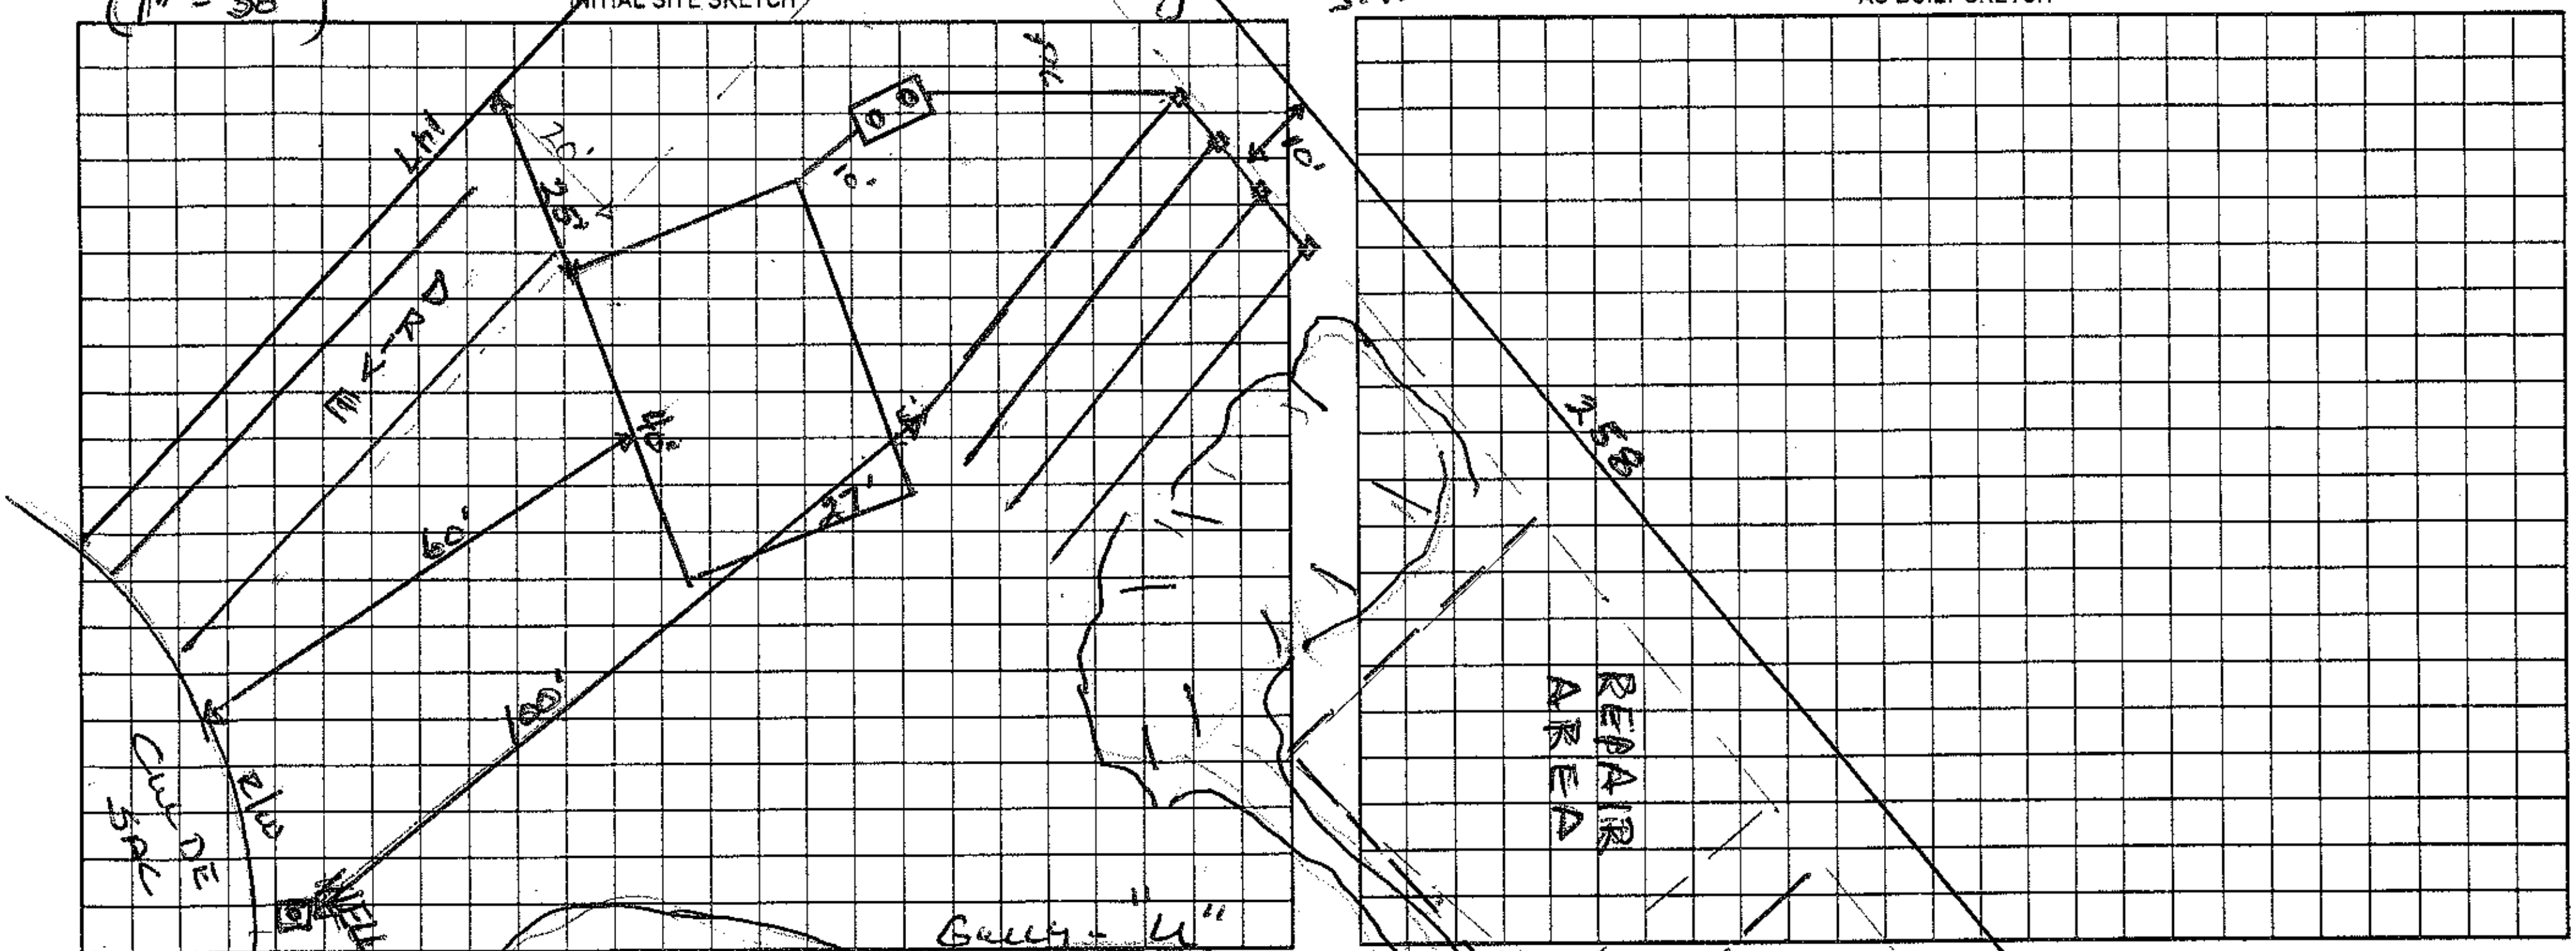

Permit can be suspended or revoked if any false information is supplied toward securing the permit/any unauthorized changes are made to the site/any unauthorized changes are made in the installation of the system. Improvement Permit with plat valid without expiration. Improvement Permit with site plan valid for sixty months. Authorization to Construct is valid for a period equal to that of Improvement Permit – not to exceed sixty months.

Signed: X [signature] date 2-17-04 Installed by: Wendell Caldwell Grading

Improvement Permit by: Wesley Sparks RS. date 2/11/04 Operation Permit by: Wesley Sparks RS. date 3/4/05

Authorization to Construct by: Wesley Sparks RS. date 11/23/04 Existing System Inspection by: date

HEALTH DEPT. COPY: WHITE OWNER COPY (FINAL): YELLOW OWNER COPY (INITIAL): PINK