IREDELL COUNTY HEALTH DEPARTMENT

Authorization to Construct — 2 3rd

STATESVILLE 704-878-5305 MOORESVILLE 704-664-5281

IMPROVEMENT PERMIT / ~~CERTIFICATE OF COMPLETION~~ / OPERATION PERMIT / EXISTING SYSTEM INSPECTION

PROPERTY DESCRIPTION NO. 23968 DATE 6/17/96 TAX MAP NO. 2N-5-A-10 Watershed: ☑ Yes ☐ No

OWNER OR CONTRACTOR Jeanie Webb ~~PHONE: Business~~ ph# 463-11-7440 Home 795-5294 WS IV

ADDRESS 115 Eastcliff Dr. SE #17 Concord NC 28025

LOCATION 150 V - TR Robinson Rd - TL Rustic Way 3rd lot from end on Left.

SUBDIVISION East Lake BLOCK / SECTION ____ LOT 10 LOT AREA ±.5 ac SITE CLASS. PS DESIGN FLOW 360 gal L.T.A.R. .3 gpd/ft²

Septic Tank: 1000 Gallons; STB ____ Date ____

Pump Tank: ____ Gallons; PT ____ Date ____

Pump Make: ____ Model ____ Serial No. ____

Nitrification Field: No Fields 1 Square Feet 900 Linear Feet 300

No Lines 7 Trench Width 36" Max Trench Bottom Depth 36" Gravel Depth N/A

☑ New System ☐ Repair System Type: I, II, III, IV, V, VI

System Description: County Chambered

Repair System Description: (Deeded before 1983)

Maintenance Agreement Required: ☐ Yes ☑ No

☑ House/Mod. Home No. Bedrooms 3

☐ Mobile Home No. Bathrooms 2

☐ Business No. Employees ____

☐ Other ____


☐ Slab ☑ Crawl Space ☐ Basement w/plumbing ☐ Basement wo/plumbing

Water Supply: ☑ Individual ☐ Community ☐ Public

Comments:

Comments: Installed as shown -

INITIAL SITE SKETCH

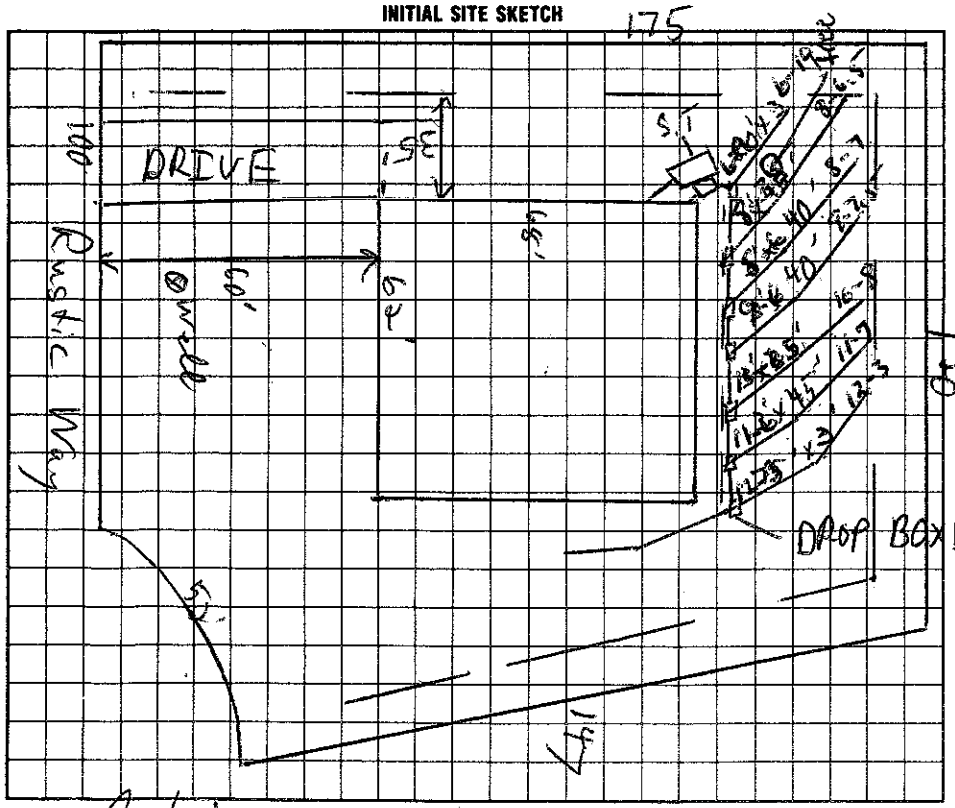

AS BUILT SKETCH

I understand that this permit can be suspended or revoked if any false information is supplied toward securing the permit/any unauthorized changes are made to the site/any unauthorized changes are made in the installation of the system.

Signed: Robert Allen for Jeanie Webb

Installed by: F I Erwin

Improvement Permit by: C. Ruby Thurman EHSE date 6/17/96

Authorization to Construct ~~Existing System Inspection~~ by: C. Ruby Thurman EHSE date 6/17/96

Certificate of Completion by: Wesley Sparks R.S. date 6/5/97

Operation Permit by: Wesley Sparks R.S. date 6/5/97

HEALTH DEPT. COPY: WHITE INSPECTION COPY (FINAL): GREEN OWNER COPY (FINAL): YELLOW INSPECTION COPY (INITIAL): PINK OWNER COPY (INITIAL): GOLD