IREDELL COUNTY HEALTH DEPARTMENT

Authorization to Construct 4638121510

TATESVILLE 704-878-5305 MOORESVILLE 704-664-5281

IMPROVEMENT PERMIT / ~~CERTIFICATE OF COMPLETION~~ / OPERATION PERMIT / EXISTING SYSTEM INSPECTION

PROPERTY DESCRIPTION NO. 24213 DATE 6/27/96 TAX MAP NO. 2N 1A 216 Watershed: [X] Yes [ ] No

OWNER OR CONTRACTOR Tom Caudle PHONE: Business _____ Home 784-1130

ADDRESS 115 Stacybrooke Dr. Concord, NC 28025

LOCATION 150 @ TR Robinson Rd. pass Melrose Ln. to 2nd drive on (L)

SUBDIVISION C L + T BLOCK / SECTION 11 LOT 21½ LOT AREA ~.7Ac SITE CLASS. PS DESIGN FLOW 240 L.T.A.R. .3

Septic Tank: 1000 Gallons; STB 794 Date 3-13-96

Pump Tank: _____ Gallons; PT _____ Date _____

Pump Make: _____ Model _____ Serial No. _____

Nitrification Field: No Fields 1 Square Feet 800 Linear Feet 267

No Lines 3 Trench Width 36" Max Trench Bottom Depth 36" Gravel Depth 12"

[X] New System [ ] Repair System Type: I (II) III. IV. V. VI

System Description: GRAV - CONV.

Repair System Description: PRES - CONV.

Maintenance Agreement Required: [ ] Yes [X] No

[ ] House/Mod. Home No. Bedrooms 2

[X] Mobile Home No. Bathrooms 2

[ ] Business No. Employees ____

[ ] Other _____


[ ] Slab [X] Crawl Space [ ] Basement w/plumbing [ ] Basement wo/plumbing

Water Supply: [X] Individual [ ] Community [ ] Public


Comments:

Comments:

INITIAL SITE SKETCH

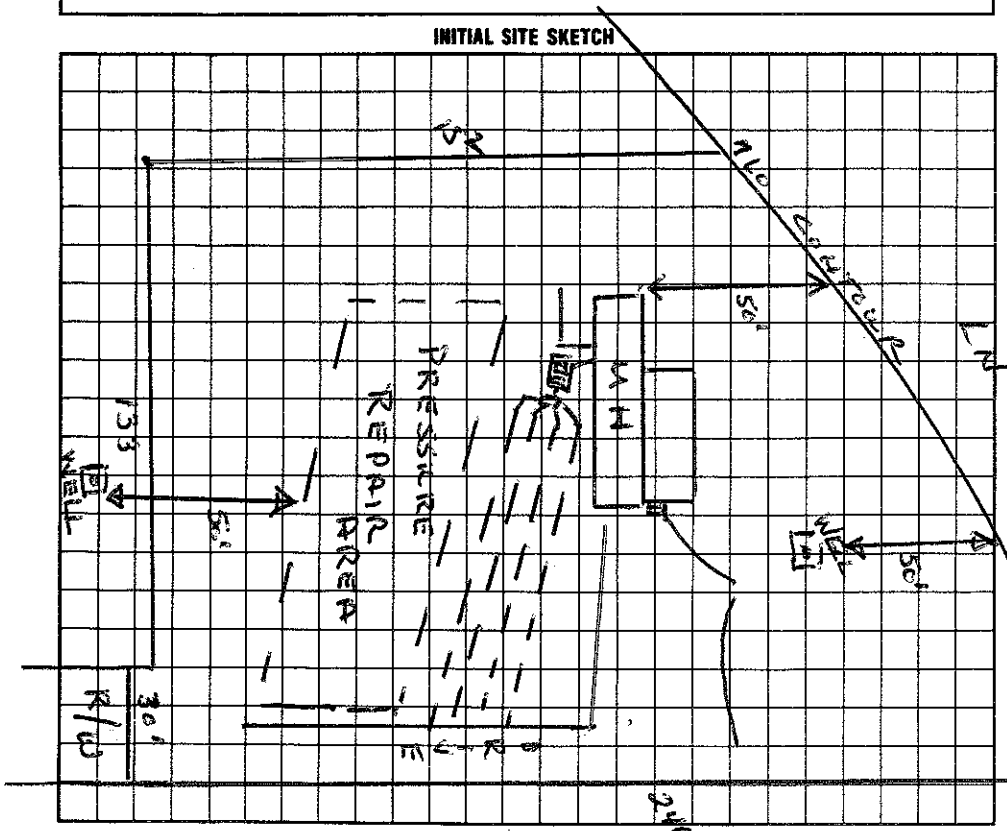

AS BUILT SKETCH

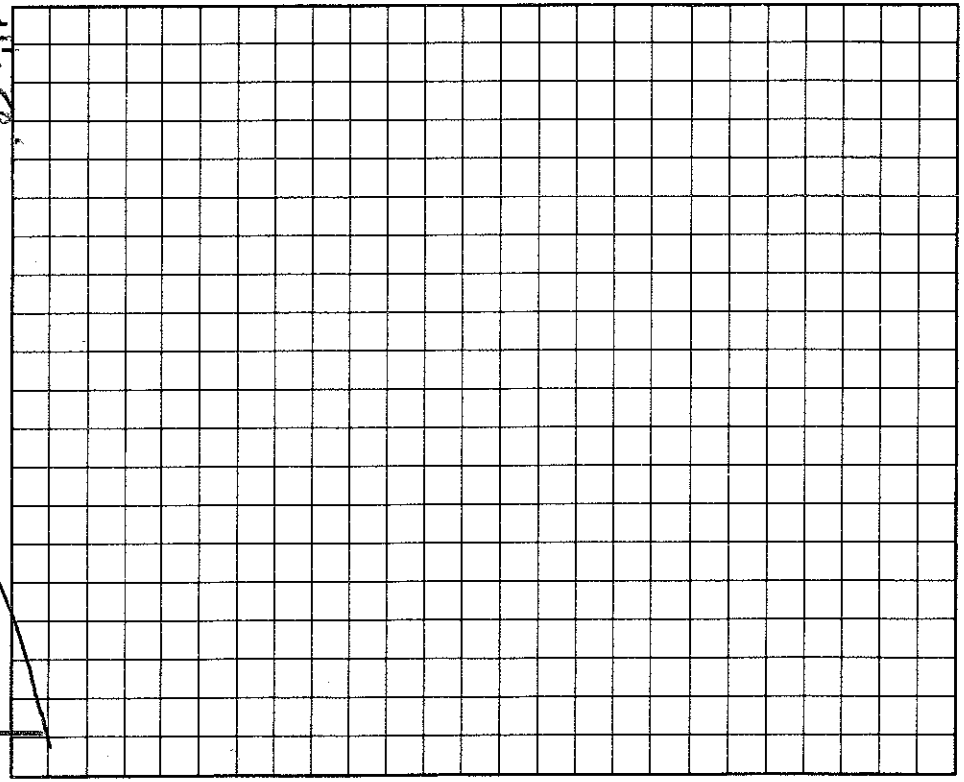

I understand that this permit can be suspended or revoked if any false information is supplied toward securing the permit/any unauthorized changes are made to the site/any unauthorized changes are made in the installation of the system.

Authorization to Construct valid 60 months.

Signed: [signature] Tom Caudle Jr.

Improvement Permit by: Wesley Sparks R.S. date 6/27/96

Existing System Inspection by: Authorization to Construct Wesley Sparks R.S. date 6/27/96

Installed by: CBC Company

Certificate of Completion by: _____ date _____

Operation Permit by: [signature] date 7/10/96

HEALTH DEPT. COPY: WHITE INSPECTION COPY (FINAL): GREEN OWNER COPY (FINAL): YELLOW INSPECTION COPY (INITIAL): PINK OWNER COPY (INITIAL): GOLD