IREDELL COUNTY HEALTH DEPARTMENT

Statesville Phone TR 3-7271 Mooresville Phone NO 3-1271

PERMIT TO INSTALL SEPTIC TANK

Permit No. _____ Permit Date 7 June 1967

Cont Owner J. L. Evans Address Chart.

Installed By Slagle + Winchester Address Chart.


Location of Property Sect. 11 - Lot 214 + 215

Tank		Capacity		Length of Lines		Fixtures	
Block	( )	1000	( )	225'	(✓)	No. of Baths	( )
Precast	(✓)	1250	( )	250'	( )	Dishwasher	( )
		1500	( )	Other _____		Garbage Grdr.	( )
		Other _____				Other _____	

NOTIFY HEALTH DEPARTMENT AT LEAST EIGHT HOURS BEFORE TANK IS TO BE INSPECTED.

Final Inspection 7 June 1967 Approved (✓) Disapproved ( )

Remarks _____

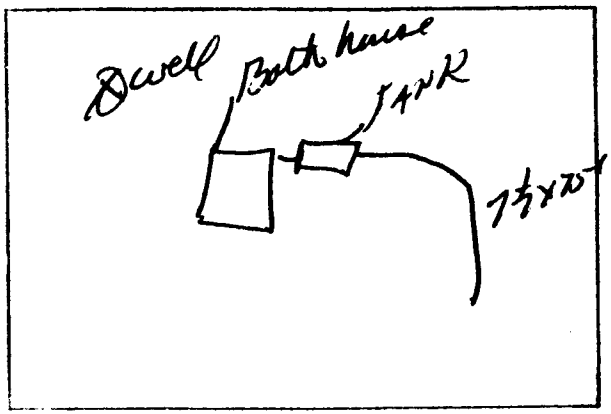

Sketch of Installation

Ray Hopkins

Sanitarian