IREDELL COUNTY HEALTH DEPARTMENT

STATESVILLE 704-878-5305 700.00 Paid MOORESVILLE 704-664-5281

IMPROVEMENT PERMIT / AUTHORIZATION TO CONSTRUCT / OPERATION PERMIT / EXISTING SYSTEM INSPECTION

PERMIT# 130528 PIN# 4638 12 6118.000 DATE 10/11/05

OWNER OR APPLICANT Haws Builders PHONE: Business 704-663-2251 Home

ADDRESS 199 Robinson Rd. Mooresville, NC. 28117

LOCATION River Hwy W TR Robinson Rd. TL Melrose Lane, 1st drive on R 2.40 Miles

SUBDIVISION WILLS LANE BLOCK / SECTION LOT 3 LOT AREA 1.56 AC SITE CLASS. PS DESIGN FLOW ~~360~~ L.T.A.R. 3 Beds

Septic Tank: 1000 Gallons; STB 794 Date 4/25/06

Pump Tank: 1000 Gallons; PT 283 Date 4/19/06

Pump Make: Gould Model SJE3 Serial No K05L190AM3

Nitrification Field: No Fields 1 Square Feet ~~330~~ 330 Linear Feet ~~210~~ 210

No Lines ~~2 @ 70~~ 3 @ 70 Trench Width 3' Max Trench Bottom Depth 3'

Gravel Depth No ☐ Gravity ☒ Pressure ☐ Slab ☒ Crawl Space ☒ Basement w/plumbing ☐ Basement wo/plumbing

☒ New System ☐ Repair ☐ Expansion System Type: I II III IV V VI

System Description: LA - PPBPS

Repair System Description: Some Type

Maintenance Agreement Required: ☒ Yes ☐ No

☒ House/Mod. Home ☐ Mobile Home ☐ Business ☐ Other

No. Bedrooms 3 No. Persons 2 No. Employees

Water Supply: ☐ Individual ☐ Public ☐ Community


Comments:/Conditions:

Limits must be on contour, exactly 10' from Robinson Rd R/w

Comments:/Conditions: 3' Pressure Head on drainfield.

(1" = 100')

INITIAL SITE SKETCH

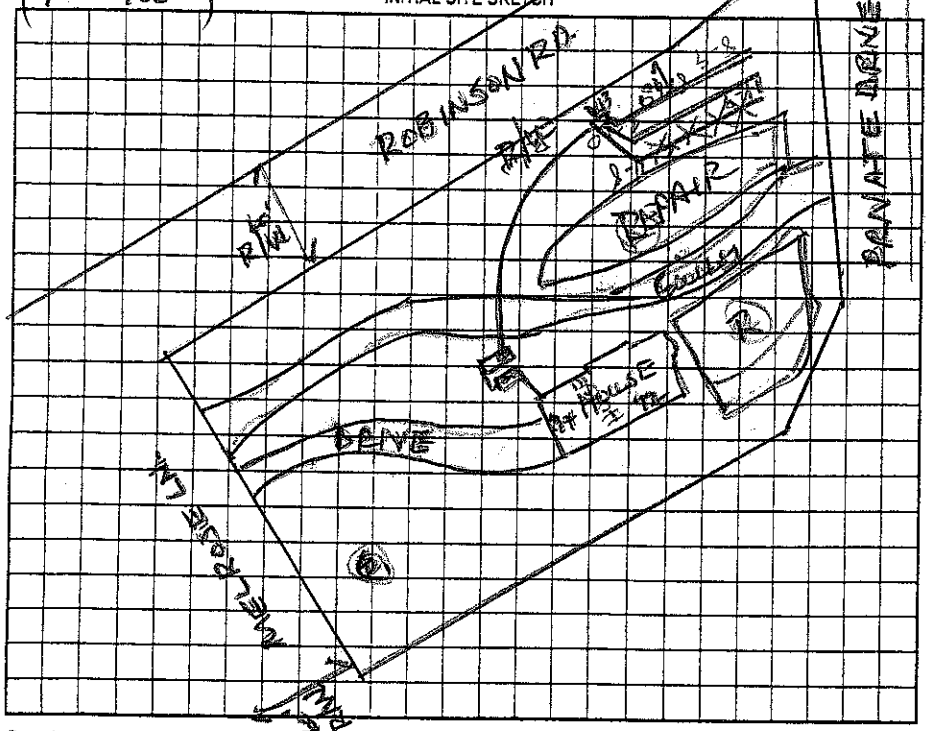

AS BUILT SKETCH

Permit can be suspended or revoked if any false information is supplied toward securing the permit/any unauthorized changes are made to the site/any unauthorized changes are made in the installation of the system. Improvement Permit with plat valid without expiration ☐ Improvement Permit with site plan valid for sixty months ☒ Authorization to Construct is valid for a period equal to that of Improvement Permit – not to exceed sixty months.

Signed: X date 10/31/05 Installed by: Larry Beam

Improvement Permit by: Wesley Sparks RS. date 10/11/05 Operation Permit by: Wesley Sparks RS. date 7/5/06

Authorization to Construct by: Wesley Sparks RS date 10/11/05 Existing System Inspection by: date

HEALTH DEPT. COPY: WHITE OWNER COPY (FINAL): YELLOW OWNER COPY (INITIAL): PINK