IREDELL COUNTY HEALTH DEPARTMENT
Authorization to Construct [STATE]SVILLE 704-878-5305 MOORESVILLE 704-664-5281 (4:30) 10:00-10:15

IMPROVEMENT PERMIT / ~~CERTIFICATE OF COMPLETION~~ / OPERATION PERMIT / EXISTING SYSTEM INSPECTION

PROPERTY DESCRIPTION NO. 067203 DATE 6/11/97 TAX MAP NO. 4638126765 Watershed: ☒ Yes ☐ No

OWNER OR CONTRACTOR RONALD ASHBURNER PHONE: Business 704-753-1096 Home

ADDRESS 242 ROBINSON RD. MOORESVILLE, NC 28115

LOCATION 150W TR ROBINSON RD. ON (R) JUST PAST KOINIA LN

SUBDIVISION ROBINSON WOODS BLOCK / SECTION LOT 28 LOT AREA .75 SITE CLASS. PS DESIGN FLOW 360 L.T.A.R. .3

Septic Tank: 1000 Gallons; STB 794 Date 7/25/97
Pump Tank: Gallons; PT Date
Pump Make: Model Serial No.
Nitrification Field: No Fields 1 Square Feet 1200 Linear Feet 400
No Lines 4 Trench Width 36" Max Trench Bottom Depth 36" Gravel Depth 12"

☒ New System ☐ Repair System Type: I (II) III, IV, V, VI
System Description: CONVENTIONAL - DIST BOX
Repair System Description: CH PLASTIC
Maintenance Agreement Required: ☐ Yes ☒ No
☐ Slab ☒ Crawl Space ☐ Basement w/plumbing ☐ Basement wo/plumbing


☒ House/Mod. Home No. Bedrooms 3
☐ Mobile Home No. Bathrooms 2
☐ Business No. Employees
☐ Other

Water Supply:
☒ Individual
☐ Community
☐ Public


Comments:

Comments:

INITIAL SITE SKETCH

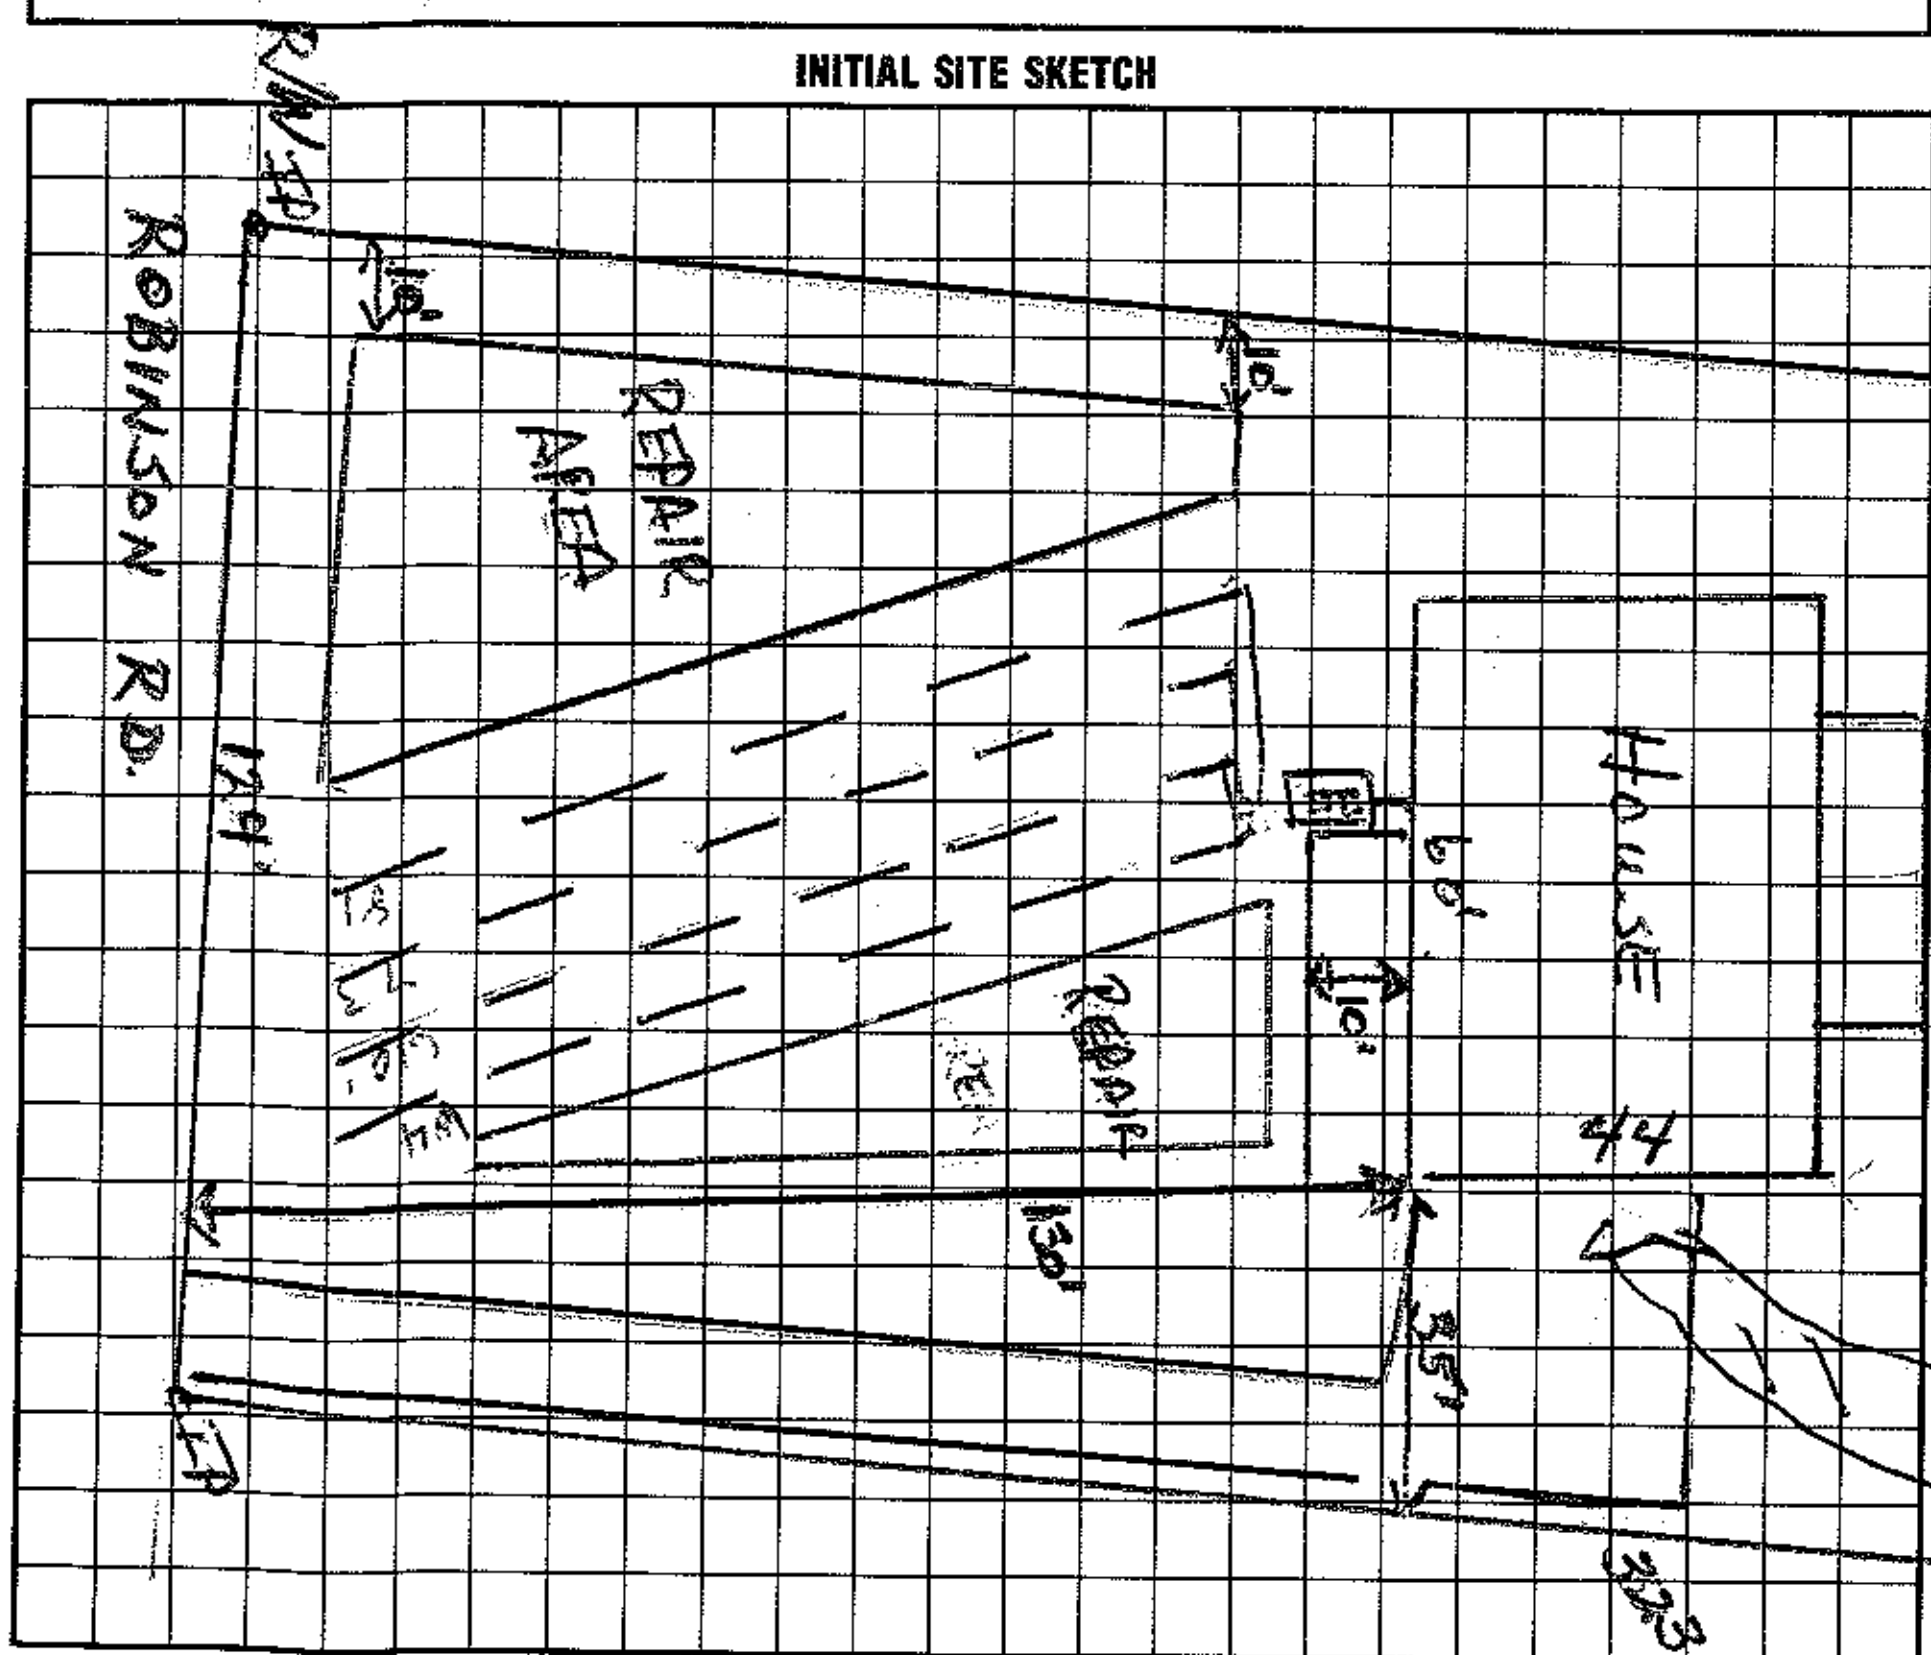

AS BUILT SKETCH

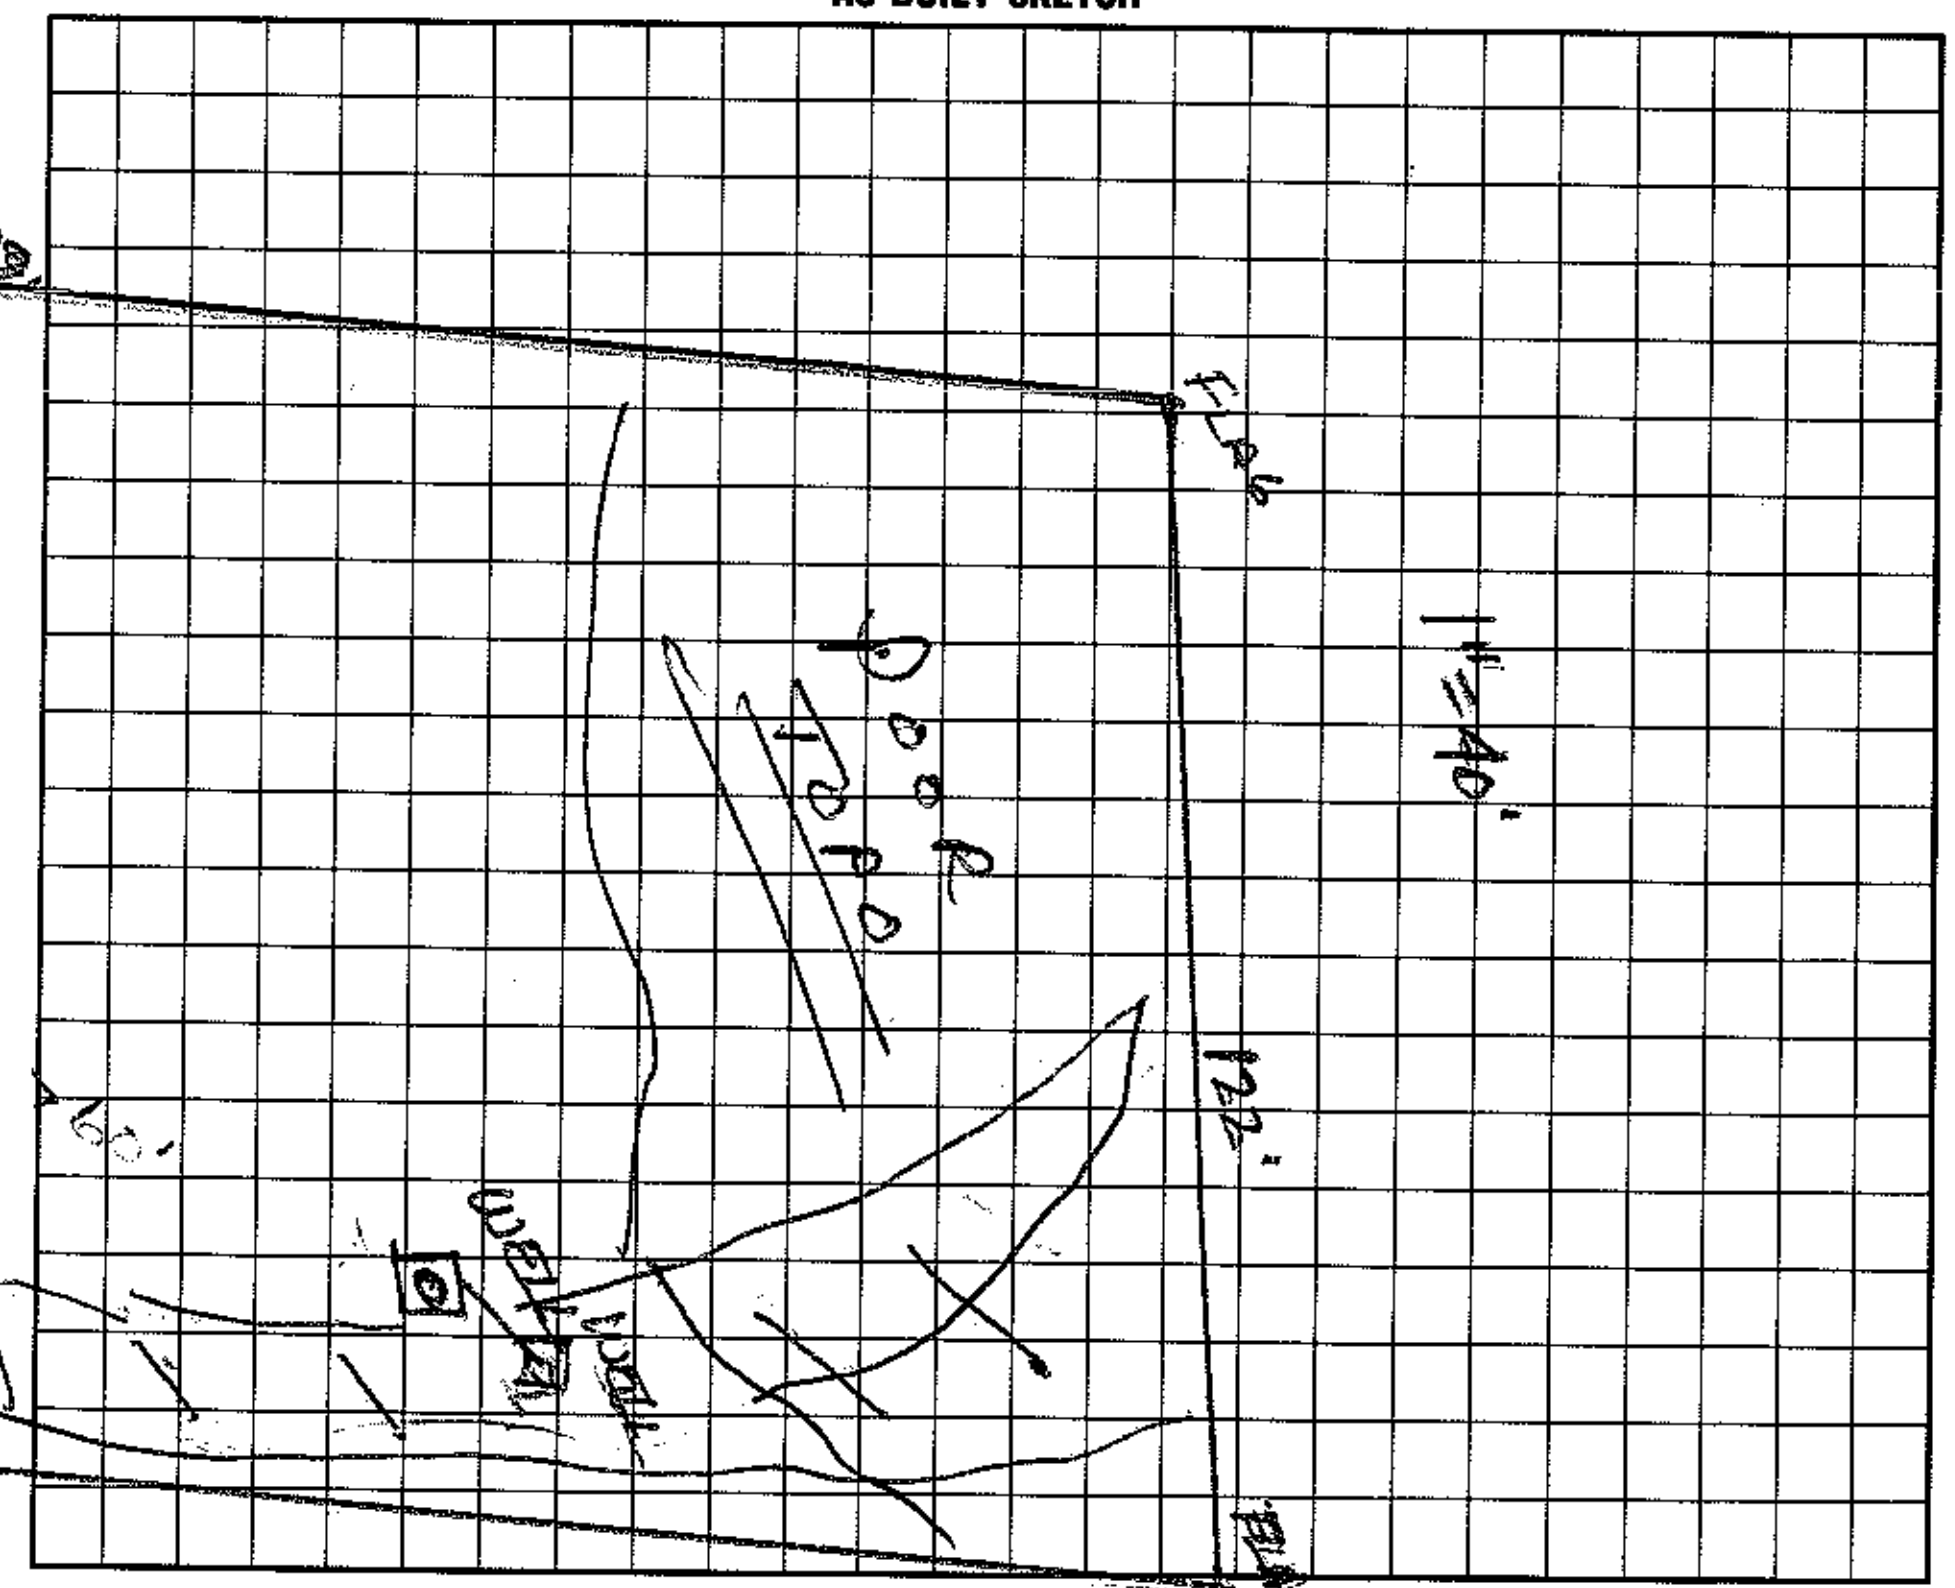

✗ I understand that this permit can be suspended or revoked if any false information is supplied toward securing the permit/any unauthorized changes are made to the site/any unauthorized changes are made in the installation of the system. Improvement Permit is valid for 60 months from date of issuance.

Signed: ✗ Jill Cruikshank

Improvement Permit by: Wesley Sparks RS. date 6/11/97

Authorization to Construct / Existing System Inspection by: Wesley Sparks RS. date 6/11/97

Installed by: DENVER PLUMBING

Certificate of Completion by: date

Operation Permit by: C. Brady Brannon date 10/22/97

HEALTH DEPT. COPY: WHITE | INSPECTION COPY (FINAL): GREEN | OWNER COPY (FINAL): YELLOW | INSPECTION COPY (INITIAL): PINK | OWNER COPY (INITIAL): GOLD