IREDELL COUNTY HEALTH DEPARTMENT

Authorization to Construct

STATESVILLE 704-878-5305 MOORESVILLE 704-664-5281

IMPROVEMENT PERMIT / ~~CERTIFICATE OF COMPLETION~~ / OPERATION PERMIT / EXISTING SYSTEM INSPECTION

PROPERTY DESCRIPTION NO. 23348 DATE 4/11/96 TAX MAP NO. 2N-1-A-29 Watershed: ☐ Yes ☑ No

OWNER OR CONTRACTOR Barbara Sabo PHONE: Business 4038-12-68116 Home 663-5226

ADDRESS 6 Crayton Ct; Dix Hills, NY 11746

LOCATION 150 - TR Robinson Rd - lot on Rt past Melrose Ln

SUBDIVISION Robinson Woods BLOCK / SECTION ____ LOT 29 LOT AREA 1.82 ac SITE CLASS. RS DESIGN FLOW ~~440~~ 330 gpd L.T.A.R. .3 gpd/sq ft

Septic Tank: 1000 Gallons; STB 317 Date 5/16/00

Pump Tank: ____ Gallons; PT ____ Date ____

Pump Make: ____ Model ____ Serial No. ____

Nitrification Field: No Fields 1 Square Feet 1200 Linear Feet 400

No Lines 4 Trench Width 36" Max Trench Bottom Depth 36" Gravel Depth N/A

☑ New System ☐ Repair System Type: I, II, ☑ III, IV, V, VI

System Description: Gravity Chamberrock

Repair System Description: Same

Maintenance Agreement Required: ☐ Yes ☑ No

☑ House/Mod. Home ☐ Mobile Home ☐ Business ☐ Other

No. Bedrooms 4 No. Bathrooms 4 No. Employees ____

☐ Slab ☑ Crawl Space ☐ Basement w/plumbing ☐ Basement wo/plumbing


Water Supply: ☑ Individual ☐ Community ☐ Public

Comments:


Comments: 8/3/00 No well on site

INITIAL SITE SKETCH

1" = 60

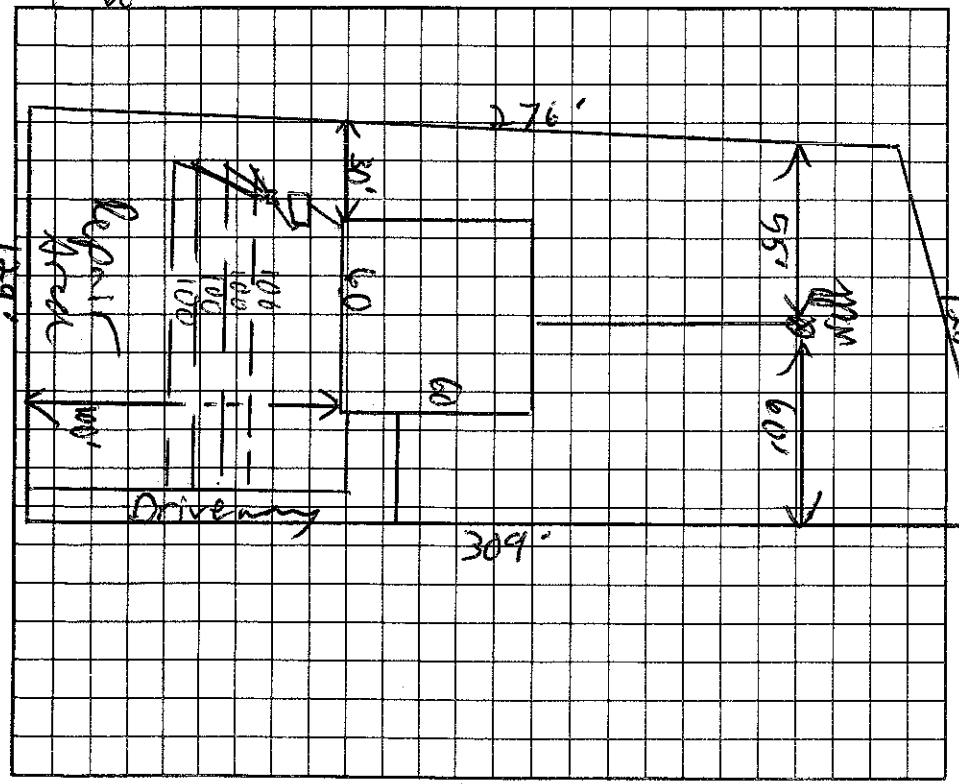

AS BUILT SKETCH

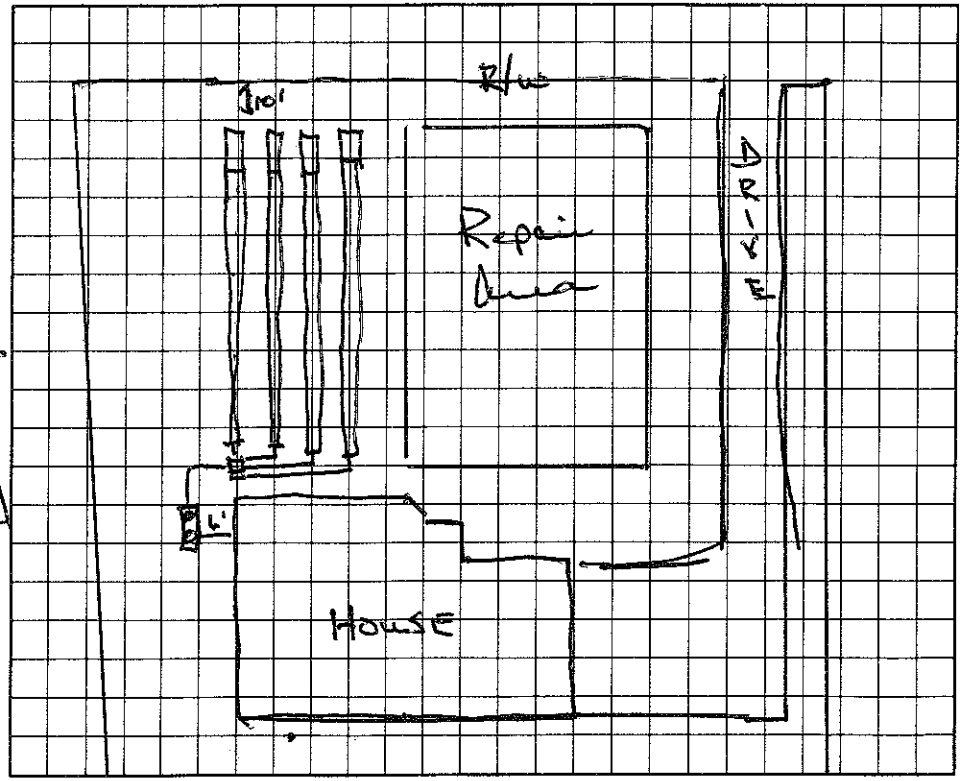

I understand that this permit can be suspended or revoked if any false information is supplied toward securing the permit/any unauthorized changes are made to the site/any unauthorized changes are made in the installation of the system.

Signed: Linda Summerville

Installed by: Bob McCraven

Improvement Permit by: C. Brady Freeman EHSI date 4/11/96

Existing System Inspection by: C. Brady Freeman EHSI date 4/16/96

Certificate of Completion by: ____ date ____

Operation Permit by: Wesley Sparks RS. date 8/3/00

HEALTH DEPT. COPY: WHITE INSPECTION COPY (FINAL): GREEN OWNER COPY (FINAL): YELLOW INSPECTION COPY (INITIAL): PINK OWNER COPY (INITIAL): GOLD

Authorization to Construct is valid for 60 months from issue date