IREDELL COUNTY HEALTH DEPARTMENT

Authorization to Construct

STATESVILLE 704-878-5305 | MOORESVILLE 704-664-5281

IMPROVEMENT PERMIT / ~~CERTIFICATE OF COMPLETION~~ / OPERATION PERMIT / EXISTING SYSTEM INSPECTION

11:30

PROPERTY DESCRIPTION NO. 23262 DATE 3/18/96 TAX MAP NO. 2N-A-43

OWNER OR CONTRACTOR Scott Allan Schell PHONE: Business 4638-12-8502 Home 599-1742

ADDRESS 7329 Winery Ln Charlotte NC 28227 Watershed: ☑ Yes ☐ No

LOCATION 150 W. of Robinson Rd - on Rt. across from McRae Ln

SUBDIVISION Robinson Woods BLOCK / SECTION II LOT 26 LOT AREA 1.18ac SITE CLASS PS DESIGN FLOW 360gpd L.T.A.R. .35 gpd/sq ft

Septic Tank: 1000 Gallons; STB 714 Date 11/3/97

Pump Tank: _____ Gallons; PT _____ Date _____

Pump Make: _____ Model _____ Serial No. _____

Nitrification Field: No Fields 1 Square Feet 1028 Linear Feet 342

No Lines 3 Trench Width 36" Max Trench Bottom Depth 36" Gravel Depth 12"

☑ New System ☐ Repair System Type: I II III IV V VI

System Description: Gravity Conventional

Repair System Description: Gravity Chambered

Maintenance Agreement Required: ☐ Yes ☑ No

☑ House/Mod. Home No. Bedrooms 3

☐ Mobile Home No. Bathrooms 2

☐ Business No. Employees _____

☐ Other _____


☐ Slab ☑ Crawl Space ☐ Basement w/plumbing ☐ Basement wo/plumbing

Water Supply: ☑ Individual ☐ Community ☐ Public


Comments: Drainfield must be 10' downslope and 15' sideslope from garage drain.

Comments:

INITIAL SITE SKETCH

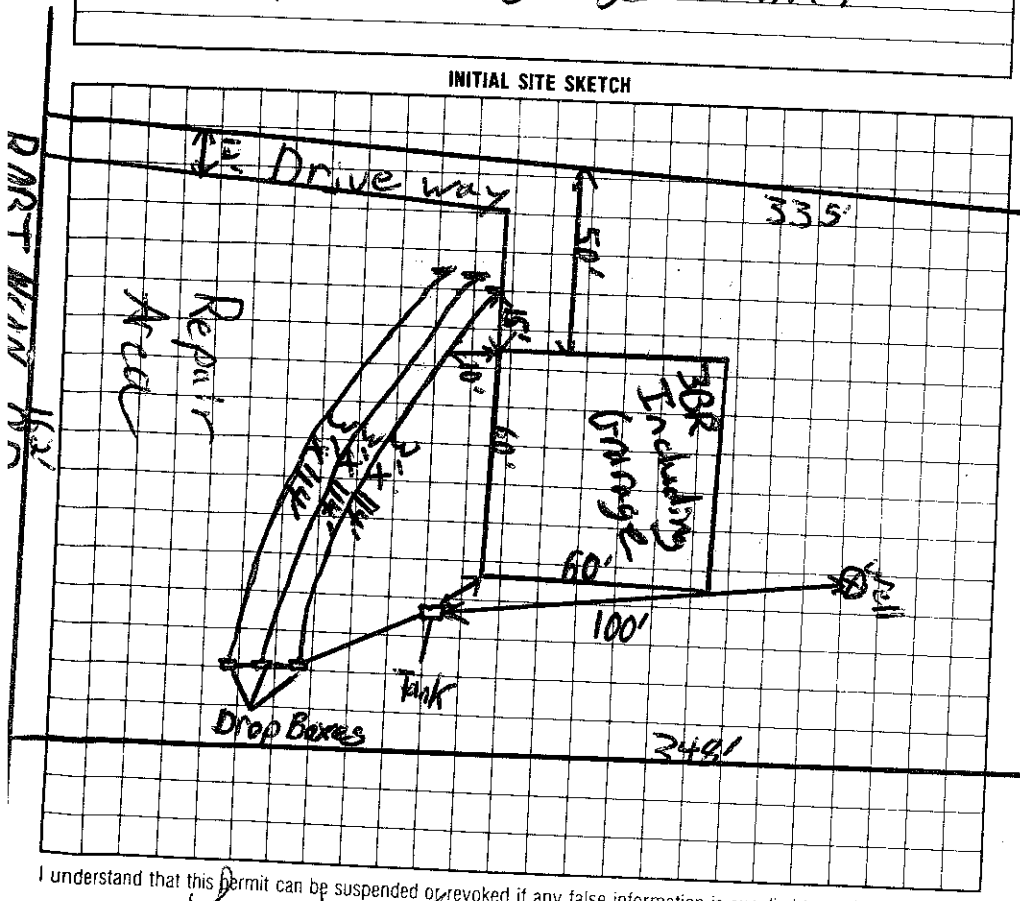

AS BUILT SKETCH

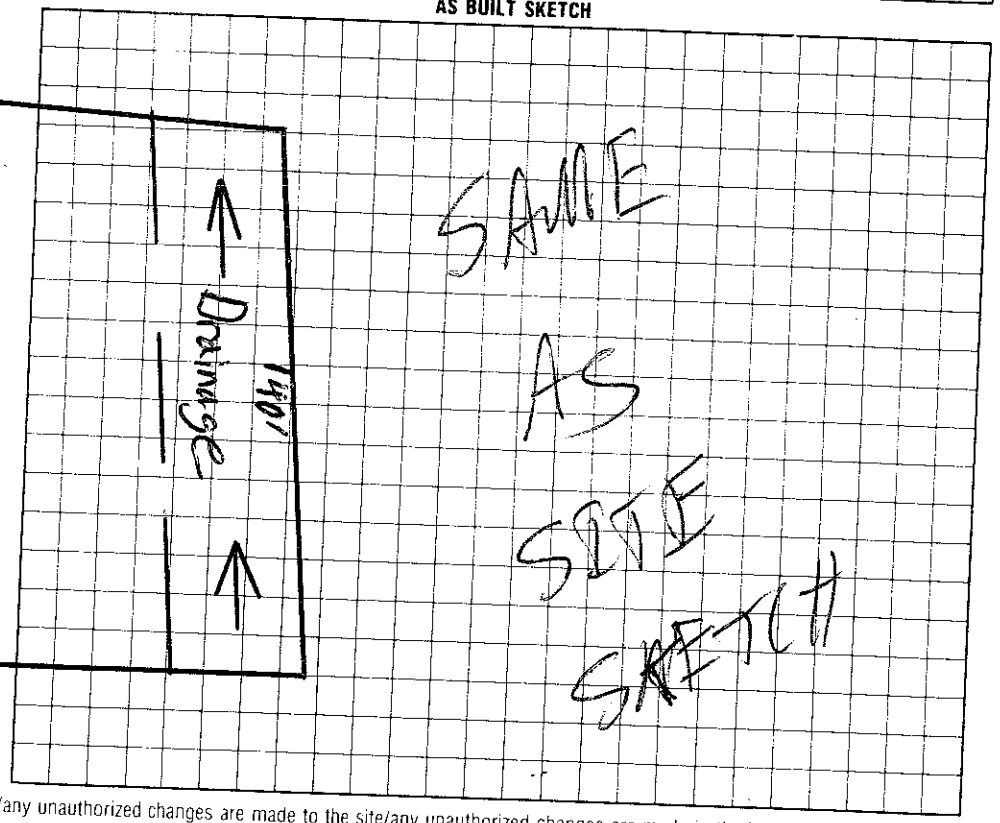

I understand that this permit can be suspended or revoked if any false information is supplied toward securing the permit/any unauthorized changes are made to the site/any unauthorized changes are made in the installation of the system.

Signed: X Linda Summerville

Improvement Permit by: C. Bridgeman EHST date 3/19/96

Existing System Inspection by: C. Bridgeman EHST date 5/17/96

Installed by: LONG GRADING

Certificate of Completion by: _____ date _____

Operation Permit by: C. Bridgeman date 2/3/97

HEALTH DEPT. COPY: WHITE INSPECTION COPY (FINAL): GREEN OWNER COPY (FINAL): YELLOW INSPECTION COPY (INITIAL): PINK OWNER COPY (INITIAL): GOLD

Authorization to Construct is valid for 60 months from date of issue.