# IREDELL COUNTY HEALTH DEPARTMENT

STATESVILLE 704-878-5305 MOORESVILLE 704-664-5281

## IMPROVEMENT PERMIT / AUTHORIZATION TO CONSTRUCT / OPERATION PERMIT / EXISTING SYSTEM INSPECTION

PERMIT# 129965 PIN# 4638130700 DATE 8-30-06

OWNER OR APPLICANT William Meritt PHONE: Business 980-721-6419 Home

ADDRESS 144 Northshore Dr Mooresville 28117

LOCATION 150 W TR Robinson Rd about 1 mi. on right

SUBDIVISION Robinson Woods BLOCK / SECTION LOT 1 LOT AREA .666 Ac SITE CLASS. PS DESIGN FLOW 360gpd L.T.A.R. .3gpd/ft²

Septic Tank: 1000 Gallons; STB 1000 Date 9/17/06
Pump Tank: Gallons; PT Date
Pump Make: Model Serial No.
Nitrification Field: No Fields 1 Square Feet 1200 Linear Feet 200
No Lines 4@50' Trench Width 24" Max Trench Bottom Depth 36"

☒ New System ☐ Repair ☐ Expansion System Type: I II (III) IV V VI
System Description: PPBPS gravity
Repair System Description: LP PPBPS
Maintenance Agreement Required: ☐ Yes ☒ No

☒ House/Mod. Home ☐ Mobile Home ☐ Business ☐ Other
No. Bedrooms 3 No. Persons 6 No. Employees

Water Supply: ☒ Individual ☐ Public ☐ Community


Gravel Depth NA ☒ Gravity ☐ Pressure ☐ Slab ☐ Crawl Space ☐ Basement w/plumbing ☒ Basement wo/plumbing

Comments/Conditions: ① For distribution use flow splitter such as Zoeller to split evenly between 4 lines ② Fill gully and keep 5' setback from system

Comments/Conditions:

1"=50'

INITIAL SITE SKETCH

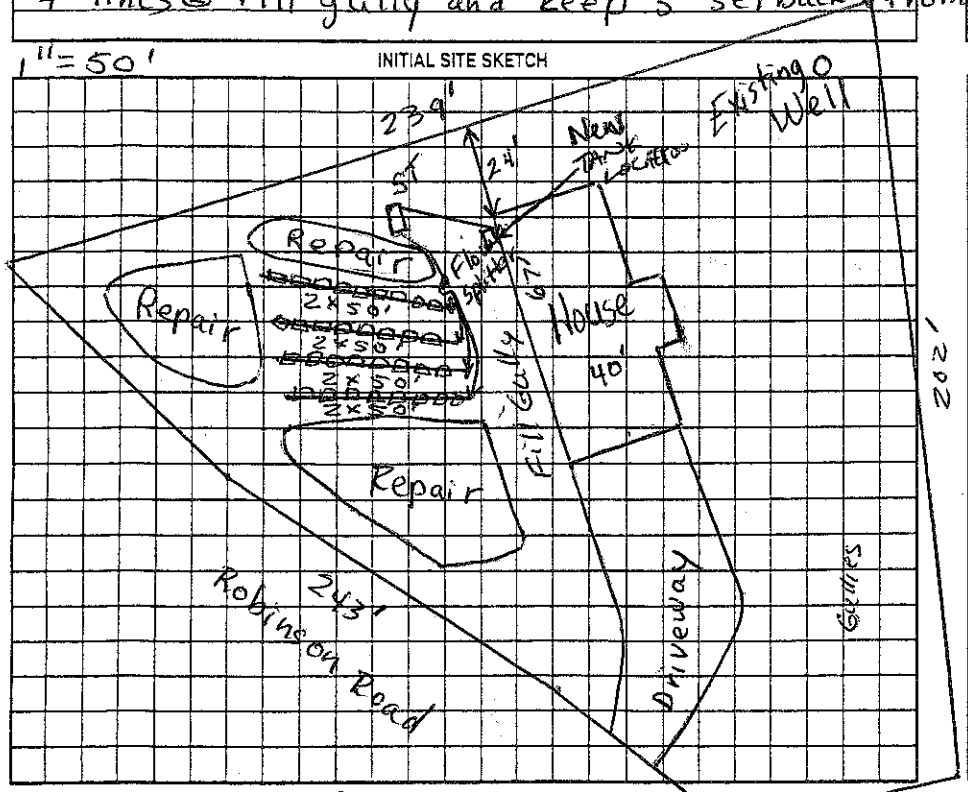


AS BUILT SKETCH

- Tank Moved to SIDE OF HOUSE (5' off DECK) To Avoid TREE ROOTS & BAD Tops
- D-Box Installed for distribution
- Tuf-Tite Filter used

Permit can be suspended or revoked if any false information is supplied toward securing the permit/any unauthorized changes are made to the site/any unauthorized changes are made in the installation of the system. Improvement Permit with plat valid without expiration. ☐ Improvement Permit with site plan valid for sixty months ☐ Authorization to Construct is valid for a period equal to that of Improvement Permit – not to exceed sixty months.

Signed: date 9/11/06 Installed by: Richard Abernathy

Improvement Permit by: Judy Melville date 8-30-06 Operation Permit by: Joseph E. Coffey date 10/25/06

Authorization to Construct by: Judy Melville date 8-30-06 Existing System Inspection by: date

HEALTH DEPT. COPY: WHITE OWNER COPY (FINAL): YELLOW OWNER COPY (INITIAL): PINK