1:30 - 2:00
LARRY BEAM

IREDELL COUNTY HEALTH DEPARTMENT

STATESVILLE 704-878-5305 — MOORESVILLE 704-664-5281

IMPROVEMENT PERMIT / AUTHORIZATION TO CONSTRUCT / OPERATION PERMIT / EXISTING SYSTEM INSPECTION

PERMIT# 95263 PIN# 4638 13 1794 DATE 9/5/01

OWNER OR CONTRACTOR Haus Builders Inc PHONE: Business 663-2251 Home

ADDRESS 288 Robinson Rd Mooresville NC 28117

LOCATION 150 W, R Robinson Rd ground Curve on Rt

SUBDIVISION Robinson Woods BLOCK / SECTION LOT 15 LOT AREA 0.58 SITE CLASS. PS DESIGN FLOW 360 L.T.A.R. 0.3

Septic Tank: 1000 Gallons; STB 312 Date 7/7/01
Pump Tank: Gallons; PT Date
Pump Make: Model Serial No.
Nitrification Field: No Fields 1 Square Feet 1200 Linear Feet 400
No Lines 4@100' Trench Width 36" Max Trench Bottom Depth 24" Gravel Depth 12"

☒ New System ☐ Repair System Type: I (II) III IV V VI
System Description: Gravity Conventional
Repair System Description: 25% Reduction
Maintenance Agreement Required: ☐ Yes ☒ No


☒ House/Mod. Home ☐ Mobile Home ☐ Business ☐ Other
No. Bedrooms 3 No. Bathrooms 2.5 No. Employees
☐ Slab ☒ Crawl Space ☐ Basement w/plumbing ☐ Basement wo/plumbing

Water Supply: ☒ Individual ☐ Public ☐ Community

Comments:/Conditions: Install lines on Contour - Keep Well 50' minimum from all septic Systems

Comments:/Conditions:

INITIAL SITE SKETCH

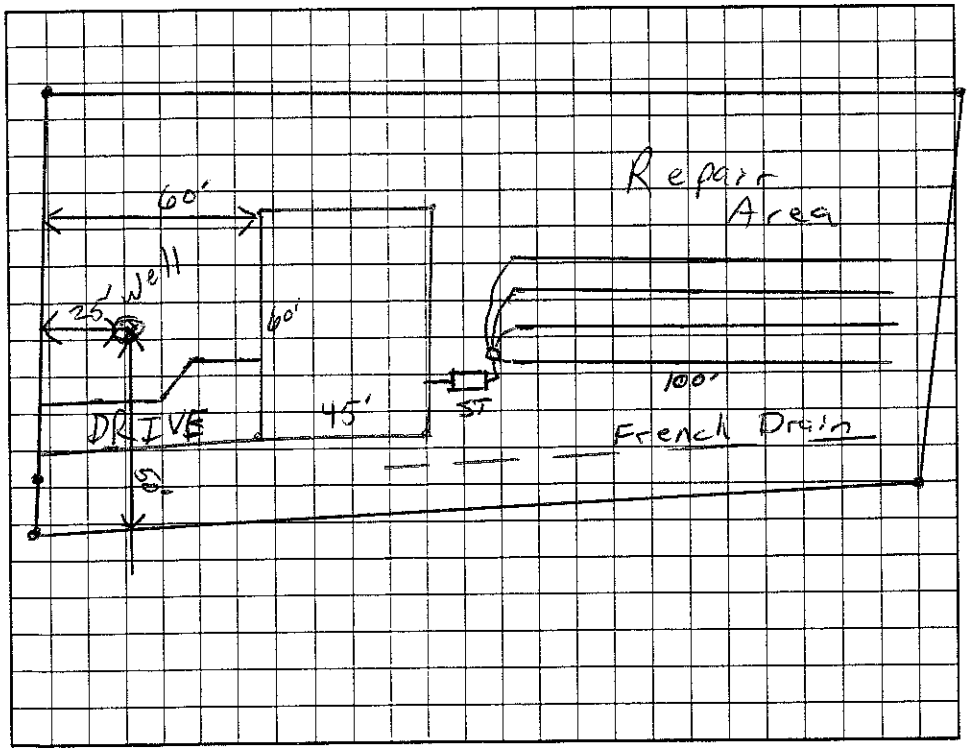

AS BUILT SKETCH

Permit can be suspended or revoked if any false information is supplied toward securing the permit/any unauthorized changes are made to the site/any unauthorized changes are made in the installation of the system. Improvement Permit with plat valid without expiration. Improvement Permit with site plan valid for sixty months. Authorization to Construct is valid for a period equal to that of Improvement Permit – not to exceed sixty months.

Signed: date 9/10/01

Improvement Permit by: RSI date 9/5/01

Authorization to Construct by: RSI date 9/5/01

Installed by: Larry Beam

Operation Permit by: RSI date 8/15/01

Existing System Inspection by: date

HEALTH DEPT. COPY: WHITE OWNER COPY (FINAL): YELLOW OWNER COPY (INITIAL): PINK