IREDELL COUNTY HEALTH DEPARTMENT

STATESVILLE 704-878-5305 MOORESVILLE 704-664-3281

IMPROVEMENT PERMIT / AUTHORIZATION TO CONSTRUCT / OPERATION PERMIT / EXISTING SYSTEM INSPECTION

PERMIT# 066956 PIN# 4638 16 2624 DATE 8/3/98

OWNER OR CONTRACTOR Eric Hangfeld PHONE: Business Home 663-2251

ADDRESS 128 Bluegrass Circle Mooresville, NC. 28115

LOCATION 150 W TR on Robinson Rd. on (R) just past Melrose Lane

SUBDIVISION Robinson Woods BLOCK / SECTION II LOT 16 LOT AREA 1.64AC SITE CLASS. PS DESIGN FLOW 360 L.T.A.R. .25

Septic Tank: 1000 Gallons; STB 794 Date 10/5/98
Pump Tank: ____ Gallons; PT ____ Date ____
Pump Make: ____ Model 1080 Serial No. 360Aug
Nitrification Field: No Fields 1 Square Feet ~~1440~~ Linear Feet ~~480~~
No Lines 6 (3+3) Trench Width 36" Max Trench Bottom Depth 36" Gravel Depth SAND

☑ New System ☐ Repair System Type: I, II, III, IV, V, VI
System Description: Flow Divider - CH. Plastic
Repair System Description: Same
Maintenance Agreement Required: ☐ Yes ☒ No


☒ House/Mod. Home No. Bedrooms 3
☐ Mobile Home No. Bathrooms 3
☐ Business No. Employees ____
☐ Other ____
☐ Slab ☒ Crawl Space ☐ Basement w/plumbing ☐ Basement wo/plumbing

Water Supply:
☒ Individual
☐ Public
☐ Community


Comments:/Conditions:

Comments:/Conditions:

INITIAL SITE SKETCH

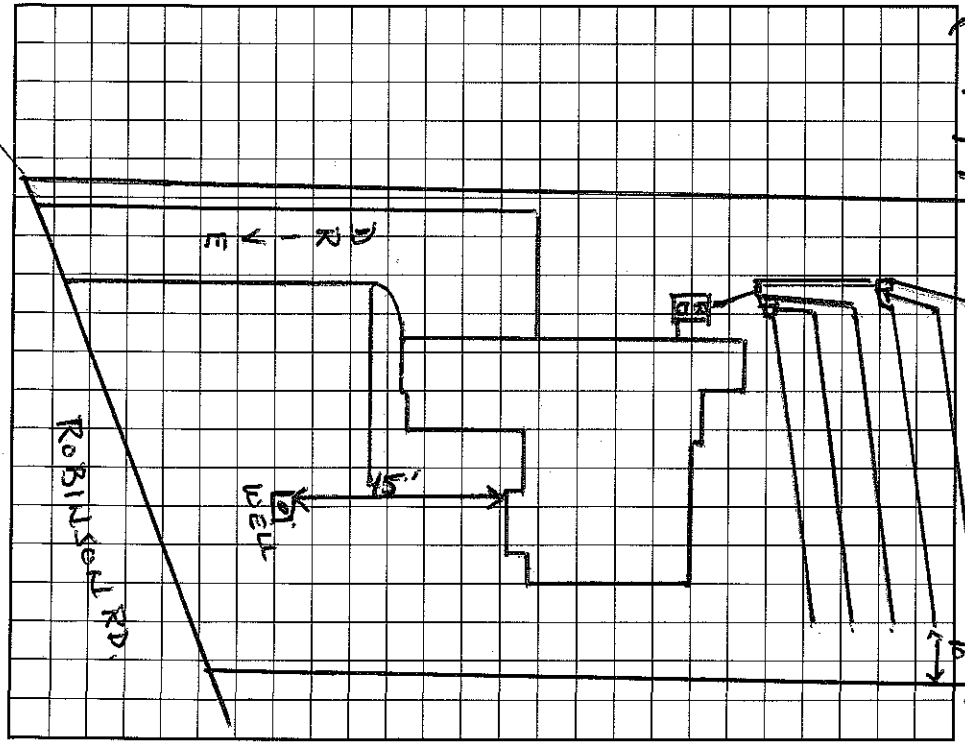

AS BUILT SKETCH

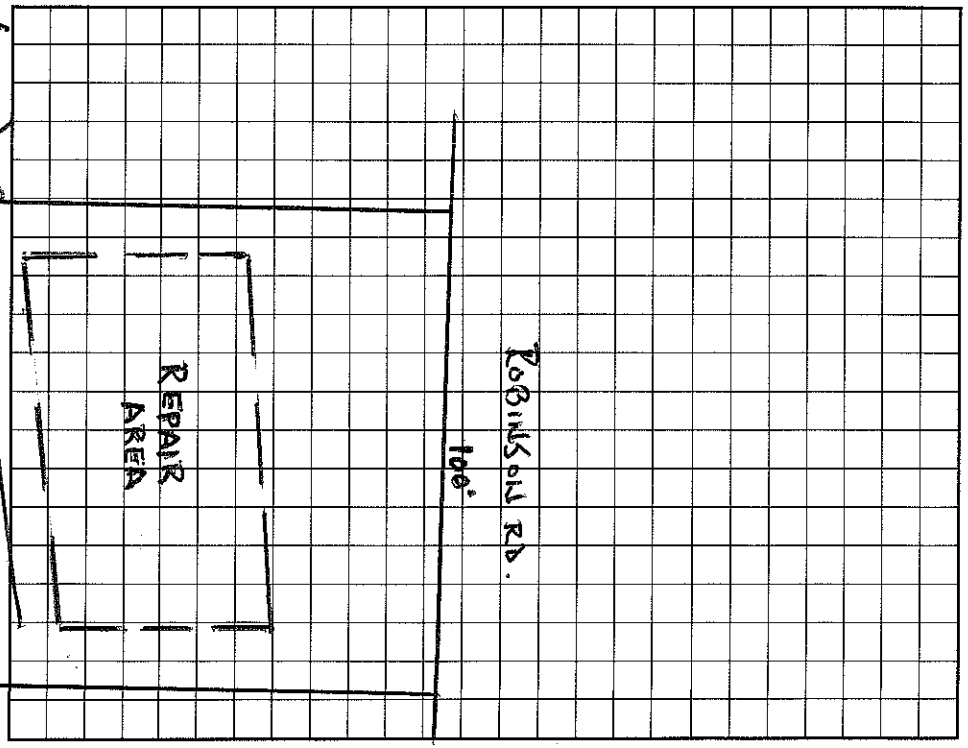

I understand that this permit can be suspended or revoked if any false information is supplied toward securing the permit/any unauthorized changes are made to the site/any unauthorized changes are made in the installation of the system. Improvement Permit with plat valid without expiration. Improvement Permit with site plan valid for sixty months. Authorization to Construct is valid for a period equal to that of Improvement Permit – not to exceed sixty months.

Signed: ____ date 8/5/98 Installed by: Larry Beam

Improvement Permit by: Wesley Sparks R.S. date 8/3/98 Operation Permit by: Wesley Sparks R.S. date 1/7/99

Authorization to Construct by: Wesley Sparks R.S. date 8/3/98 Existing System Inspection by: ____ date ____

HEALTH DEPT. COPY: WHITE INSPECTION COPY (FINAL): GREEN OWNER COPY (FINAL): YELLOW INSPECTION COPY (INITIAL): PINK OWNER COPY (INITIAL): GOLD