IREDELL COUNTY HEALTH DEPARTMENT

Authorization to Construct

10:00-10:15

STATESVILLE 704-878-5305 MOORESVILLE 704-664-5281

IMPROVEMENT PERMIT / ~~CERTIFICATE OF COMPLETION~~ / OPERATION PERMIT / EXISTING SYSTEM INSPECTION

PROPERTY DESCRIPTION NO. 066958 DATE 6/23/97 TAX MAP NO. 4638133474 Watershed: X Yes ☐ No

OWNER OR CONTRACTOR Timothy L. Whelan PHONE: Business 599-4745 Home

ADDRESS 1108 KIRKVIEW LN. Apt 103 CHARLOTTE, NC 28213

LOCATION 150 W TR ROBINSON RD. ON (R) after MELROSE LN. #274

SUBDIVISION ROBINSON WOODS BLOCK / SECTION II LOT 18 LOT AREA .65 SITE CLASS. PS DESIGN FLOW 480 L.T.A.R. .3

Septic Tank: 1000 Gallons; STB 794 Date 6/1/97

Pump Tank: Gallons; PT Date

Pump Make: Model Serial No.

Nitrification Field: No Fields 1 Square Feet 1200* Linear Feet 400*

No Lines 5 Trench Width 36" Max Trench Bottom Depth 38" Gravel Depth 3AND.

X New System ☐ Repair System Type: I, II, (III), IV, V, VI

System Description: GRAV-CH PLASTIC

Repair System Description: PRESSURE-CH PLASTK

Maintenance Agreement Required: ☐ Yes ☐ No

X House/Mod. Home No. Bedrooms 4

☐ Mobile Home No. Bathrooms 2.5

☐ Business No. Employees

☐ Other


☐ Slab X Crawl Space ☐ Basement w/plumbing ☐ Basement wo/plumbing

Water Supply: X Individual ☐ Community ☐ Public


Comments: * 25% Reduction for Type III Chambered Plastic Drainfield

Comments:

INITIAL SITE SKETCH

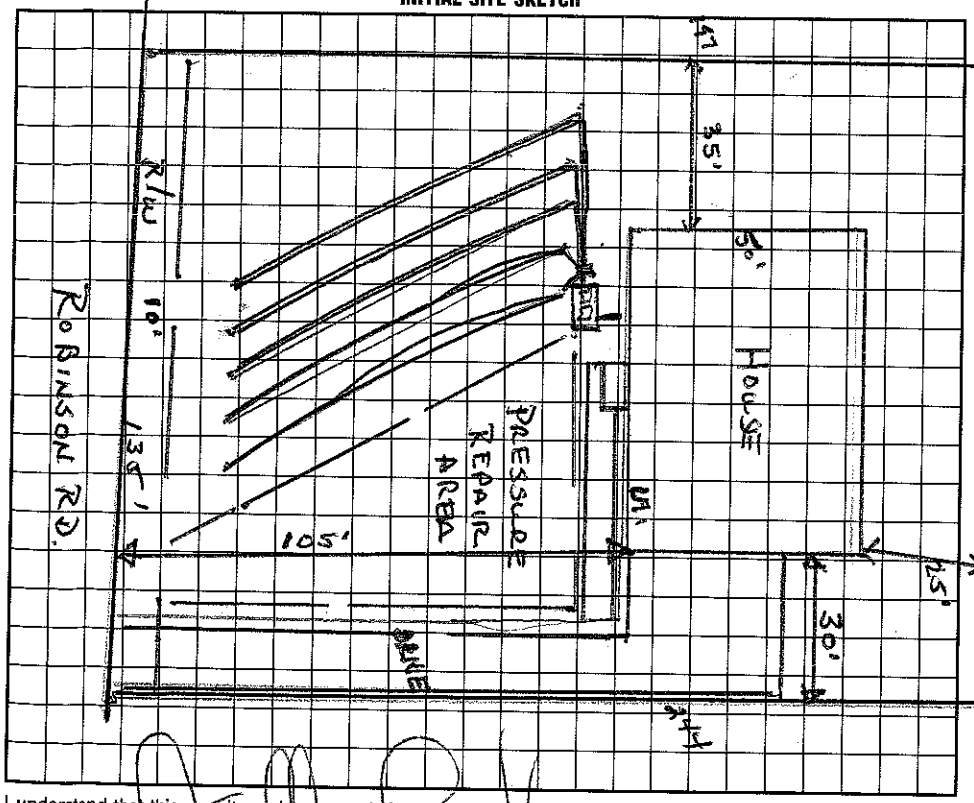

AS BUILT SKETCH

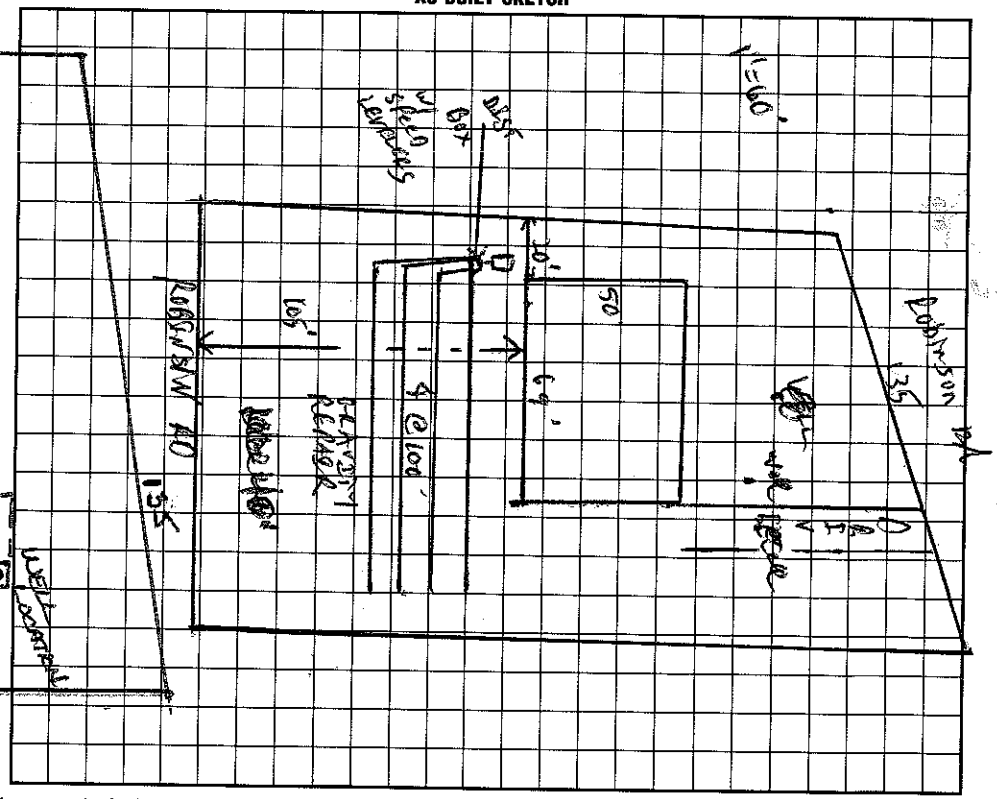

I understand that this permit can be suspended or revoked if any false information is supplied toward securing the permit/any unauthorized changes are made to the site/any unauthorized changes are made in the installation of the system. Improvement Permit is valid for 60 months from date of issuance.

Signed: X

Improvement Permit by: Wesley Sparks R.S. date 6/23/97

Existing System Inspection by: Wesley Sparks R.S. date 6/23/97

Installed by: LARRY BEAM

Certificate of Completion by: date

Operation Permit by: C. Ray Freeman R.S. date 11/20/97

HEALTH DEPT. COPY: WHITE INSPECTION COPY (FINAL): GREEN OWNER COPY (FINAL): YELLOW INSPECTION COPY (INITIAL): PINK OWNER COPY (INITIAL): GOLD