IREDELL COUNTY HEALTH DEPARTMENT

Authorization to Construct 4638-13-3505

STATESVILLE 704-878-5305 MOORESVILLE 704-664-5281

IMPROVEMENT PERMIT / ~~CERTIFICATE OF COMPLETION~~ / OPERATION PERMIT / EXISTING SYSTEM INSPECTION

PROPERTY DESCRIPTION NO. 23708 DATE 5/28/96 TAX MAP NO. 2N-A-43 pt of Watershed: ☑ Yes ☐ No

OWNER OR CONTRACTOR LaVon D. Collins PHONE: Business _____ Home 664-4398

ADDRESS 19701 A Hwy 73

LOCATION 150w- TR Robinson Rd - Lot on Rt after Melrose Lane #280

SUBDIVISION Robinson Woods BLOCK / SECTION _____ LOT #17 LOT AREA .74 ac SITE CLASS. PS DESIGN FLOW 360 gpd L.T.A.R. .39 gpd/ft²

Septic Tank: 1000 Gallons; STB 794 Date 1/21/97

Pump Tank: _____ Gallons; PT _____ Date _____

Pump Make: _____ Model _____ Serial No. _____

Nitrification Field: No Fields 1 Square Feet 1200 Linear Feet 400

No Lines 4 Trench Width 36" Max Trench Bottom Depth 36" Gravel Depth 12"

☑ New System ☐ Repair System Type: I, II, III, IV, V, VI

System Description: Gravity Conventional Sand

Repair System Description: _____

Maintenance Agreement Required: ☐ Yes ☑ No

☑ House/Mod. Home No. Bedrooms 3

☐ Mobile Home No. Bathrooms 2

☐ Business No. Employees _____

☐ Other _____


☐ Slab ☑ Crawl Space ☐ Basement w/plumbing ☐ Basement wo/plumbing

Water Supply: ☑ Individual ☐ Community ☐ Public

Comments: Lot not cleared very Well - Contours subject to change.

Comments:

INITIAL SITE SKETCH

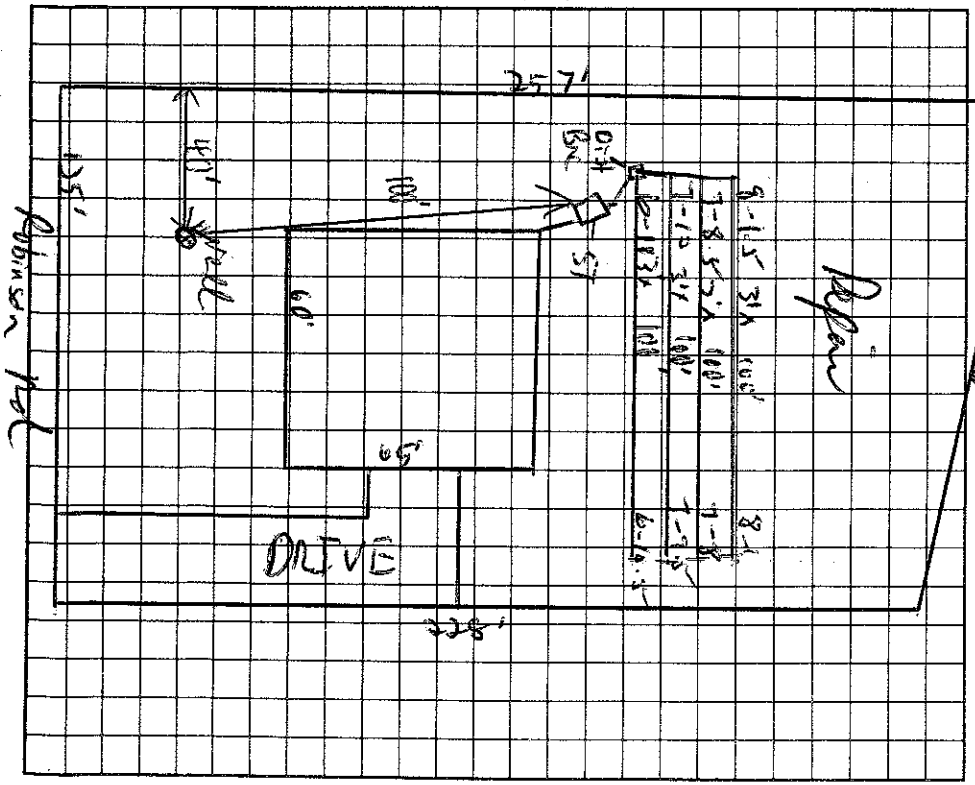

AS BUILT SKETCH

I understand that this permit can be suspended or revoked if any false information is supplied toward securing the permit/any unauthorized changes are made to the site/any unauthorized changes are made in the installation of the system.

Signed: Lee Lyn Baker

Installed by: Orbison Const. Co.

Improvement Permit by: C. Ruby Freeman EHS date 5/28/96

Authorization to Construct / ~~EXISTING System Inspection~~ by: C. Ruby Freeman EHS date 5/28/96

Certificate of Completion by: _____ date _____

Operation Permit by: Wesley Sparks RS date 3/21/97

HEALTH DEPT. COPY: WHITE INSPECTION COPY (FINAL): GREEN OWNER COPY (FINAL): YELLOW INSPECTION COPY (INITIAL): PINK OWNER COPY (INITIAL): GOLD

Authorization to Construct is Valid for 60 months from issue date.