IREDELL COUNTY HEALTH DEPARTMENT

Authorization to Construct

STATESVILLE 704-878-5305 MOORESVILLE 704-664-5281

IMPROVEMENT PERMIT / ~~CERTIFICATE OF COMPLETION~~ / OPERATION PERMIT / EXISTING SYSTEM INSPECTION

PROPERTY DESCRIPTION NO. 23523 DATE 5/1/96 TAX MAP NO. 2N-A-43 Watershed: ☑ Yes ☐ No

OWNER OR CONTRACTOR Chris Fitts PHONE: Business 4638-13-4343 Home 704-483-0750

ADDRESS 8468 Blakes trail Denver NC 28037

LOCATION 150 W - TR Robinson Rd - lot on Rt about 1 mile #268

SUBDIVISION Robinson Woods BLOCK / SECTION ____ LOT 19 LOT AREA 65 ac SITE CLASS. RS DESIGN FLOW 450 gal L.T.A.R. .5 gal/ft²

Septic Tank: 1000 Gallons; STB 794 Date 8/30/96

Pump Tank: ____ Gallons; PT ____ Date ____

Pump Make: ____ Model ____ Serial No. ____

Nitrification Field: No Fields 1 Square Feet 1200 Linear Feet 400

No Lines 4 Trench Width 36" Max Trench Bottom Depth 36" Gravel Depth N/A

☑ New System ☐ Repair System Type: I II III IV V VI

System Description: Conventional

Repair System Description: Same

Maintenance Agreement Required: ☐ Yes ☑ No

☑ House/Mod. Home ☐ Mobile Home ☐ Business ☐ Other

No. Bedrooms 3 No. Bathrooms 2.5 No. Employees ____

☐ Slab ☑ Crawl Space ☐ Basement w/plumbing ☐ Basement wo/plumbing


Water Supply: ☑ Individual ☐ Community ☐ Public

Comments:

Comments:

1" = 50'

INITIAL SITE SKETCH

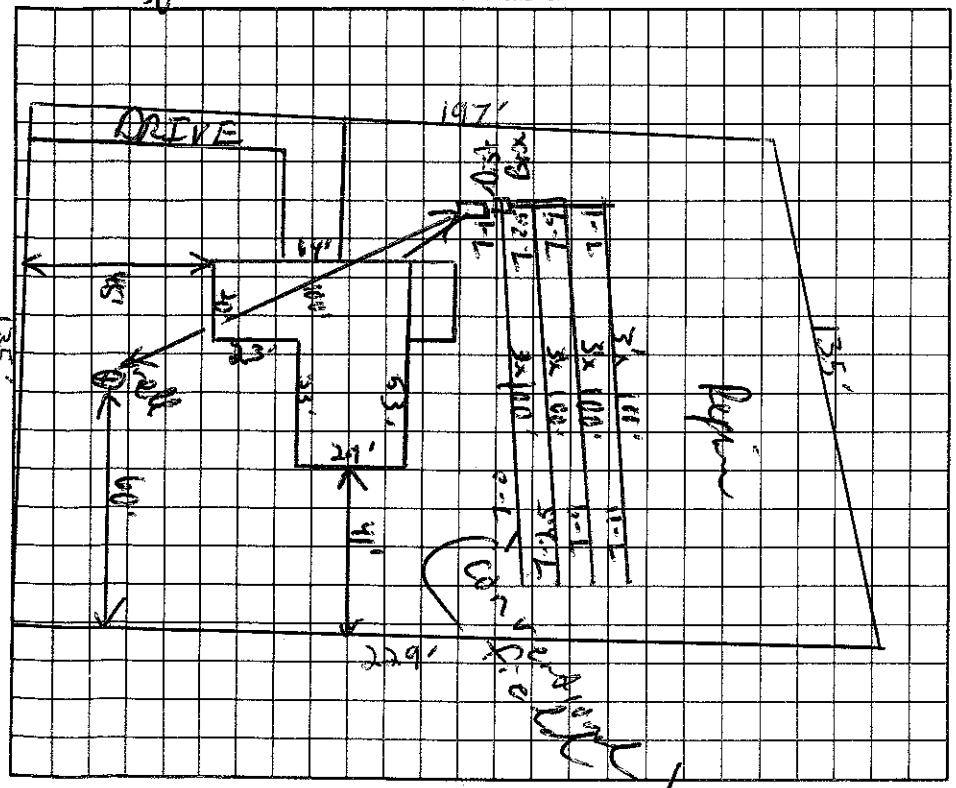

AS BUILT SKETCH

I understand that this permit can be suspended or revoked if any false information is supplied toward securing the permit/any unauthorized changes are made to the site/any unauthorized changes are made in the installation of the system.

Signed: Chris Fitts

Installed by: Dwight Avery - Ready Mix

Improvement Permit by: C. Robertson EHST date 5/1/96

Authorization to Construct by: C. Robertson EHST date 5/1/96

Certificate of Completion by: ____ date ____

Operation Permit by: Wesley Sparks RS. date 11/1/96

HEALTH DEPT. COPY: WHITE INSPECTION COPY (FINAL): GREEN OWNER COPY (FINAL): YELLOW INSPECTION COPY (INITIAL): PINK OWNER COPY (INITIAL): GOLD

Authorization to Construct is valid for 60 months from issue date.