IREDELL COUNTY HEALTH DEPARTMENT

STATESVILLE 704-878-5305 MOORESVILLE 704-664-5281

IMPROVEMENT PERMIT / AUTHORIZATION TO CONSTRUCT / OPERATION PERMIT / EXISTING SYSTEM INSPECTION

PERMIT# 071573 PIN# 4638 13 5018 DATE 11/24/98

OWNER OR CONTRACTOR Frank De Simone PHONE: Business 704-608-9070 Home

ADDRESS 811 Rothmoor Rd. Concord, NC. 28025

LOCATION 150 W, TR Robinson Rd. on (R) across from Koinia Lane

SUBDIVISION Robinson Woods BLOCK / SECTION LOT 31 LOT AREA .55AC SITE CLASS. RS DESIGN FLOW 360 L.T.A.R. .3

Septic Tank: 1000 Gallons; STB 794 Date 12/14/98
Pump Tank: Gallons; PT Date
Pump Make: Model Serial No.
Nitrification Field: No Fields 1 Square Feet 900± Linear Feet 300±
No Lines 4 Trench Width 36" Max Trench Bottom Depth 30" Gravel Depth 24in.

☒ New System ☐ Repair System Type: I, II, (III) IV, V, VI
System Description: Brentwood-CH Plastic
Repair System Description: Septic
Maintenance Agreement Required: ☐ Yes ☒ No


☒ House/Mod. Home No. Bedrooms 3
☐ Mobile Home No. Bathrooms 3
☐ Business No. Employees
☐ Other
☐ Slab ☒ Crawl Space ☐ Basement w/plumbing ☐ Basement wo/plumbing

Water Supply: ☒ Individual ☐ Public ☐ Community


Comments:/Conditions: ± 15% reduction figured

Comments:/Conditions: Diversion to be constructed by Ervin

INITIAL SITE SKETCH

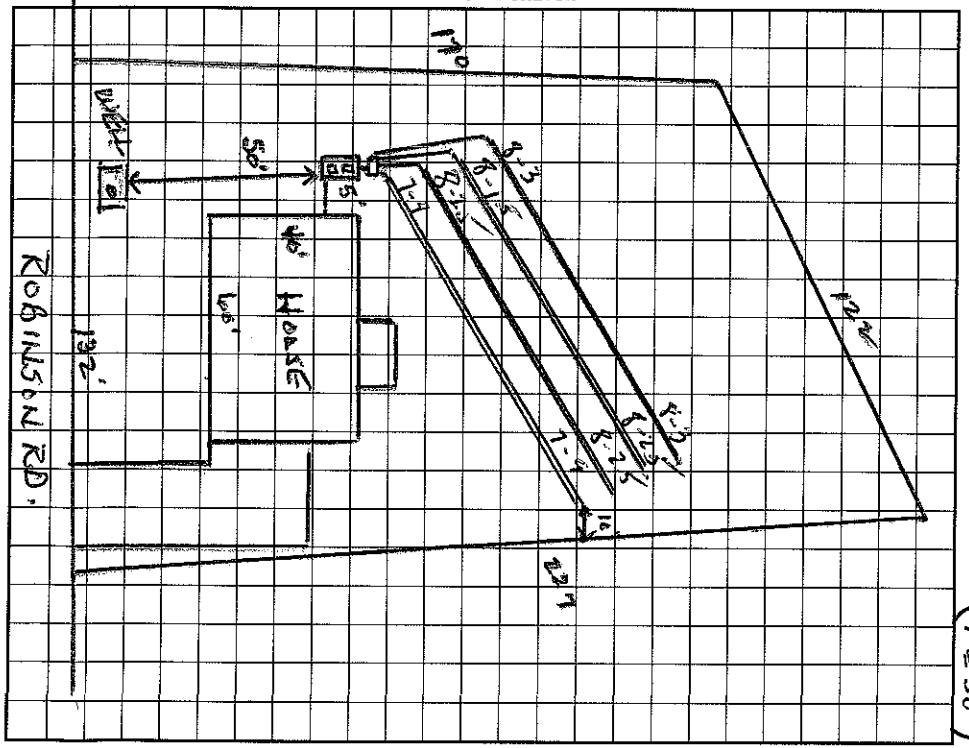

AS BUILT SKETCH

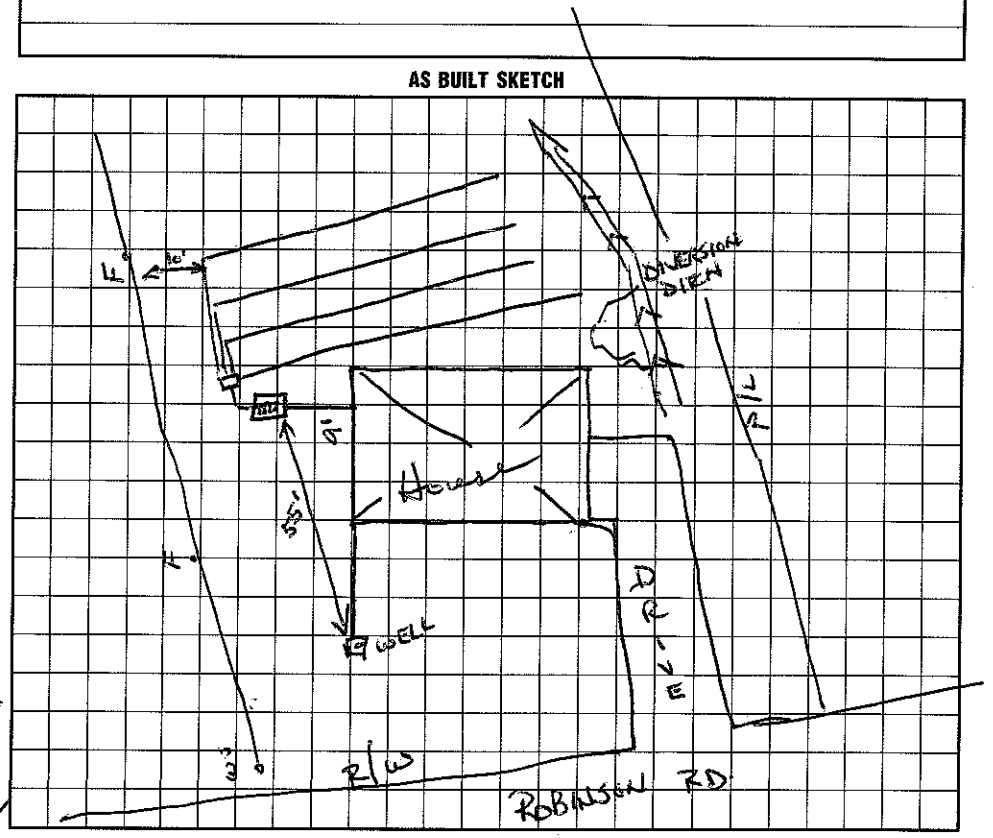

I understand that this permit can be suspended or revoked if any false information is supplied toward securing the permit/any unauthorized changes are made to the site/any unauthorized changes are made in the installation of the system. Improvement Permit with plat valid without expiration. Improvement Permit with site plan valid for sixty months. Authorization to Construct is valid for a period equal to that of Improvement Permit – not to exceed sixty months.

Signed: ± Thomas Brooks Jr date 11-30-98

Improvement Permit by: Wesley Sparks RS. date 11/25/98

Authorization to Construct by: Wesley Sparks RS. date 11/25/98

Installed by: FJ Ervin

Operation Permit by: Wesley Sparks RS. date 3/19/99

Existing System Inspection by: date

HEALTH DEPT. COPY: WHITE INSPECTION COPY (FINAL): GREEN OWNER COPY (FINAL): YELLOW INSPECTION COPY (INITIAL): PINK OWNER COPY (INITIAL): GOLD