...ELL COUNTY HEALTH DEPARTMENT

STATESVILLE 704-878-5305 MOORESVILLE 704-664-5281

IMPROVEMENT PERMIT / AUTHORIZATION TO CONSTRUCT / OPERATION PERMIT / EXISTING SYSTEM INSPECTION

PERMIT# 09111/20267 PIN# 4638 13 5822

OWNER OR CONTRACTOR Ernst Koehler

ADDRESS 480 Robinson Rd. Mooresville, NC. 28117 PHONE: Business 704-660-0267 Home

DATE 8/17/00

LOCATION 150 W TR Robinson Rd. almost at end on (L) small red Cedar house

SUBDIVISION CL+T BLOCK / SECTION 11 LOT 179 LOT AREA ~ .89 SITE CLASS PS DESIGN FLOW 480 L.T.A.R. + 3

Septic Tank: 1000 Gallons; STB 312 Date 10/9/04

Pump Tank: 1000 Gallons; PT 27 Date 10/02/04

Pump Make: GOULDS Model M3E0-312 Serial No.

Nitrification Field: No Fields 1 Square Feet 1200 Linear Feet 400

No Lines 5@80' Trench Width 36" Max Trench Bottom Depth 36" Gravel Depth SAND.

[X] New System [ ] Repair System Type: I, II, (III), IV, V, VI

System Description: PressMan - Ch. Plastic

Repair System Description: SOME < 1983

Maintenance Agreement Required: [ ] Yes [X] No

[X] House/Mod. Home [ ] Mobile Home [ ] Business [ ] Other

No. Bedrooms 4 No. Bathrooms 3 No. Employees


Water Supply: [X] Individual [ ] Public [ ] Community

[ ] Slab [X] Crawl Space [ ] Basement w/plumbing [ ] Basement wo/plumbing


Comments:/Conditions:

Comments:/Conditions: Floor Trap, Pressman Alarm

INITIAL SITE SKETCH

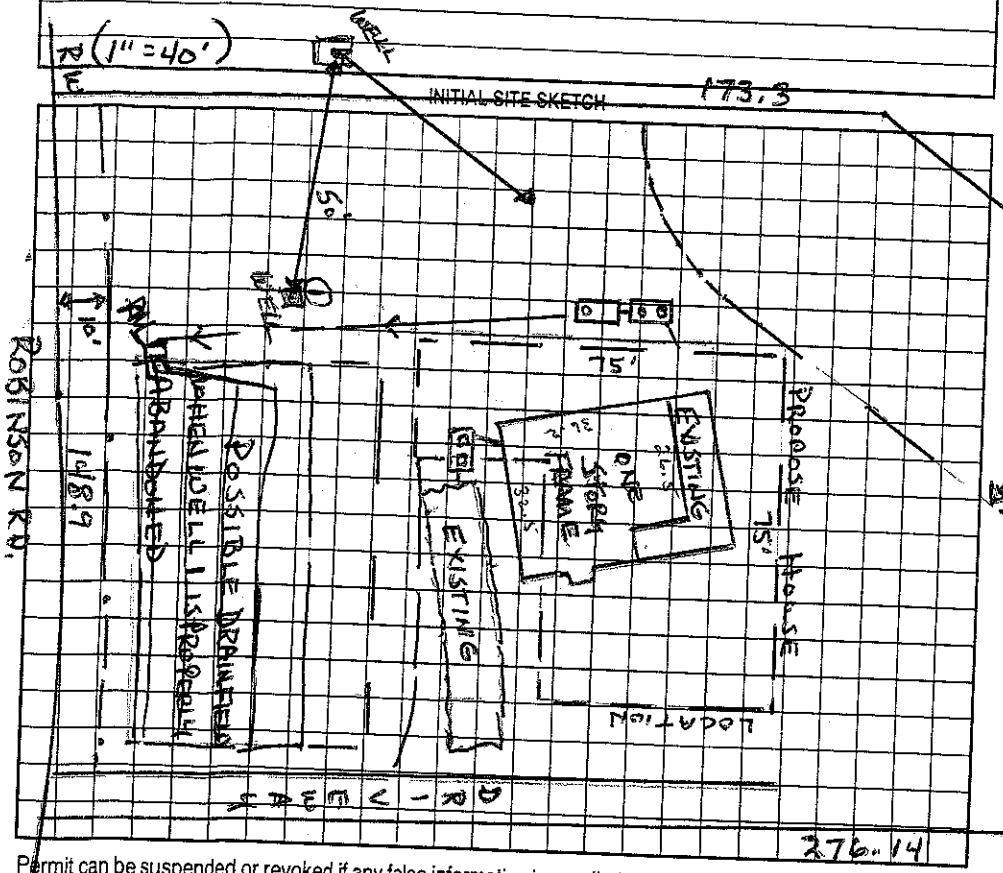

AS BUILT SKETCH

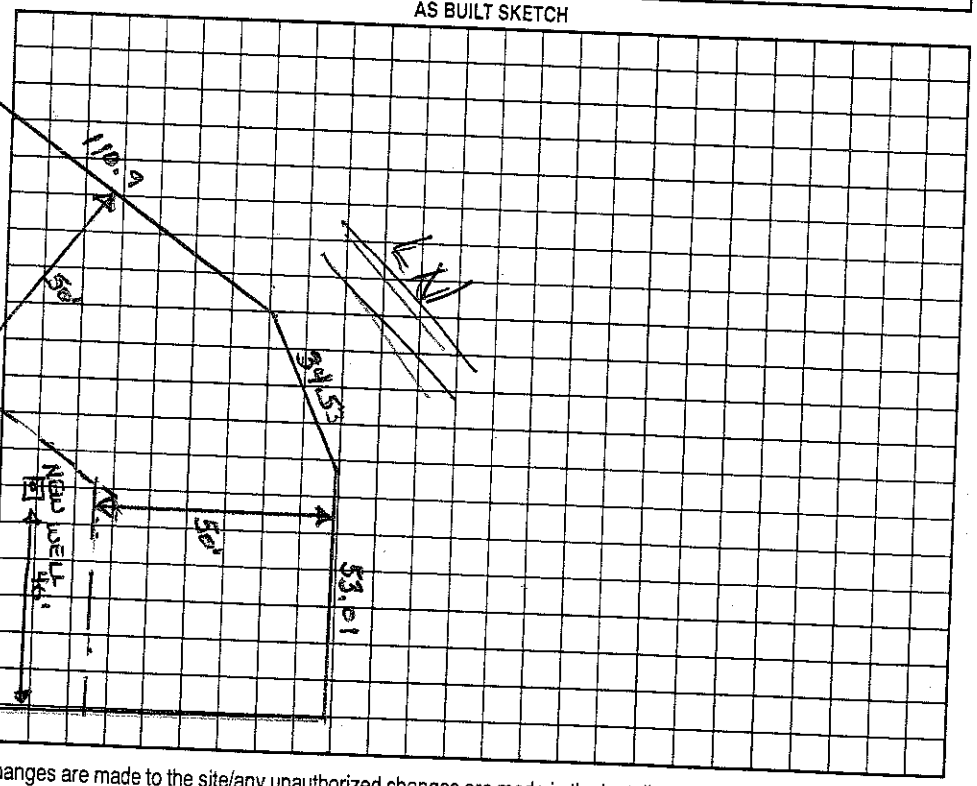

Permit can be suspended or revoked if any false information is supplied toward securing the permit/any unauthorized changes are made to the site/any unauthorized changes are made in the installation of the system. Improvement Permit with plat valid without expiration. Improvement Permit with site plan valid for sixty months. Authorization to Construct is valid for a period equal to that of Improvement Permit – not to exceed sixty months.

Signed: * Phyllis Koehler date

Improvement Permit by: Wesley Sparks R.S. date 8/17/00

Authorization to Construct by: Wesley Sparks RS date 4/12/04

Installed by: R+N

Operation Permit by: Wesley Sparks RS date 12/30/04

Existing System Inspection by: date

HEALTH DEPT. COPY: WHITE OWNER COPY (FINAL): YELLOW OWNER COPY (INITIAL): PINK