IREDELL COUNTY HEALTH DEPARTMENT

STATESVILLE 704-878-5305 700.00 Paid MOORESVILLE 704-664-5281

IMPROVEMENT PERMIT / AUTHORIZATION TO CONSTRUCT / OPERATION PERMIT / EXISTING SYSTEM INSPECTION

PERMIT# 131055 PIN# 4638 13 8089 DATE 10/7/05

OWNER OR CONTRACTOR Lyn Allen & Teresa Ford PHONE: Business 704-663-2251 Home

ADDRESS 199 Robinson Rd, PoBox 3983 Mooresville, NC. 28117

LOCATION 150 WTR Robinson Rd on (R) before cul de sac

SUBDIVISION Robinson Woods BLOCK / SECTION LOT 23 LOT AREA 1.12 AC SITE CLASS. PS DESIGN FLOW 480 L.T.A.R. .3

Septic Tank: 1000 Gallons; STB 3/2 Date 9/16/06
Pump Tank: 1000 Gallons; PT 27 Date 8/28/06
Pump Make: Goulds Model WE0 3/2 Pump No.
Nitrification Field: No Fields 1 Square Feet 1200 Linear Feet 400
No Lines 4 @ 100' Trench Width 3' Max Trench Bottom Depth 3' Gravel Depth No

[X] New System [ ] Repair System Type: [ ] II [X] III [ ] IV [ ] V [ ] VI
System Description: PM → 25% Reduction
Repair System Description: Same
Maintenance Agreement Required: [ ] Yes [X] No

[X] House/Mod. Home No. Bedrooms 4
[ ] Mobile Home No. Bathrooms 2.5
[ ] Business No. Employees
[ ] Other
[ ] Slab [ ] Crawl Space [X] Basement w/plumbing [ ] Basement wo/plumbing


Water Supply: [X] Individual [ ] Public [ ] Community

Comments:/Conditions: Lines on contour in direction shown
Keep driveway close to left side property line and out of the drainfield area


Comments:/Conditions:

1" = 50'

INITIAL SITE SKETCH

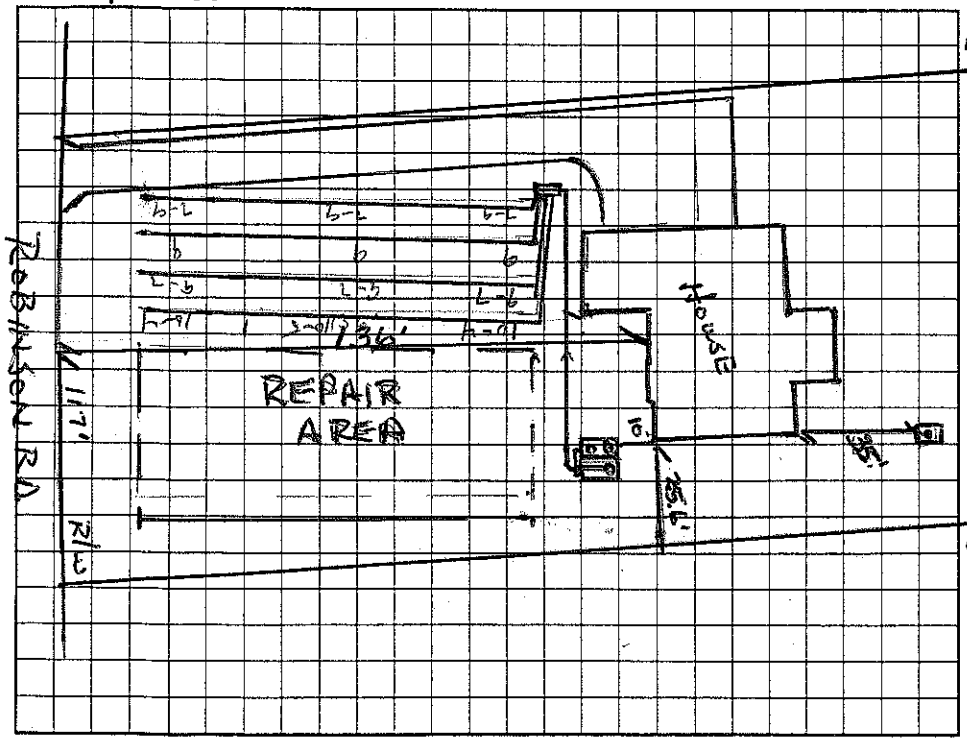

AS BUILT SKETCH

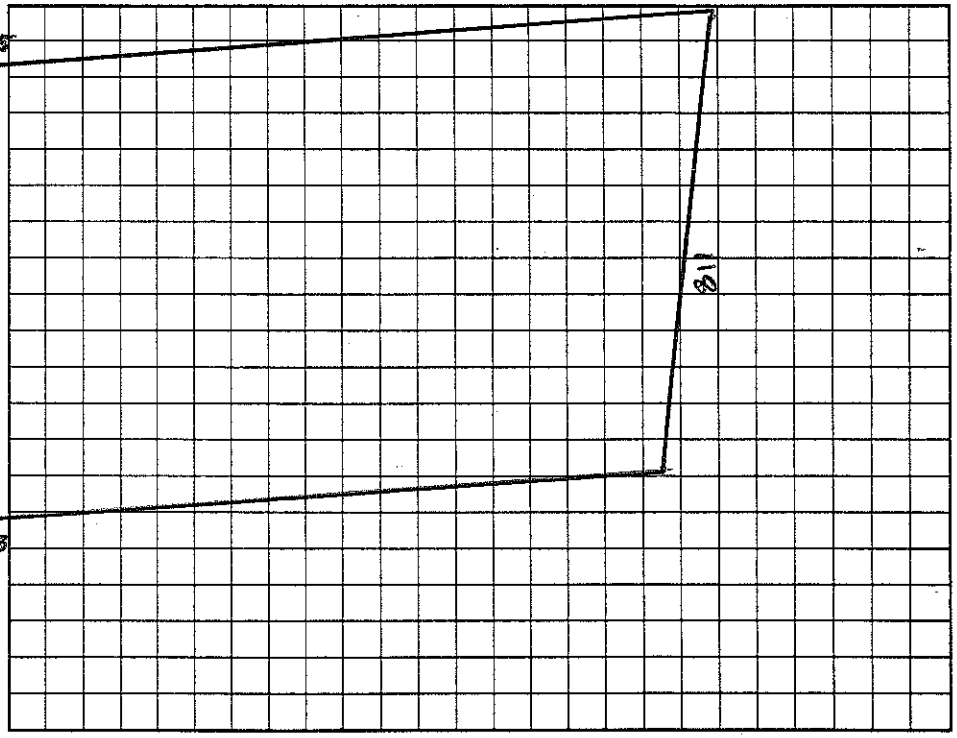

Permit can be suspended or revoked if any false information is supplied toward securing the permit/any unauthorized changes are made to the site/any unauthorized changes are made in the installation of the system. Improvement Permit with plat valid without expiration. Improvement Permit with site plan valid for sixty months. Authorization to Construct is valid for a period equal to that of Improvement Permit – not to exceed sixty months.

Signed: [signature] date 10/31/05 Installed by: Larry Beam

Improvement Permit by: Wesley Sparks R.S. date 10/7/05 Operation Permit by: Wesley Sparks R.S. date 11/8/06

Authorization to Construct by: Wesley Sparks R.S. date 10/7/05 Existing System Inspection by: date

HEALTH DEPT. COPY: WHITE OWNER COPY (FINAL): YELLOW OWNER COPY (INITIAL): PINK