IREDELL COUNTY HEALTH DEPARTMENT

Authorization to Construct

STATESVILLE 704-878-5305 MOORESVILLE 704-664-5281

IMPROVEMENT PERMIT / ~~CERTIFICATE OF COMPLETION~~ / OPERATION PERMIT / EXISTING SYSTEM INSPECTION

PROPERTY DESCRIPTION NO. 069965 DATE 11/13/97 TAX MAP NO. 4638139050 Watershed: ☒ Yes ☐ No WSIVCA

OWNER OR CONTRACTOR Ernst F ~~Kohler~~ KOEHLER PHONE: Business 892-9673 Home

ADDRESS PO Box 2383 Cornelius, NC 28031

LOCATION Robinson Rd., 150 WTR Robinson Rd on (R) just before cul de sac 480 Robinson Rd.

SUBDIVISION Robinson Woods BLOCK / SECTION LOT 24 LOT AREA 1.16AC SITE CLASS. PS DESIGN FLOW 480 L.T.A.R. .3

Septic Tank: 1000 Gallons; STB Date

Pump Tank: Gallons; PT Date

Pump Make: Model Serial No.

Nitrification Field: No Fields 1 Square Feet 1600 Linear Feet 533

No Lines 4 Trench Width 36" Max Trench Bottom Depth 36" Gravel Depth 12"

☒ New System ☐ Repair System Type: I, (II) III, IV, V, VI

System Description: GRAVITY CONVENTIONAL

Repair System Description: SAME

Maintenance Agreement Required: ☐ Yes ☒ No

☒ House/Mod. Home No. Bedrooms 4

☐ Mobile Home No. Bathrooms 2.5

☐ Business No. Employees

☐ Other


☐ Slab ☐ Crawl Space ☐ Basement w/plumbing ☒ Basement wo/plumbing

Water Supply: ☒ Individual ☐ Community ☐ Public


Comments: Lines on contour as shown here

Comments:

INITIAL SITE SKETCH

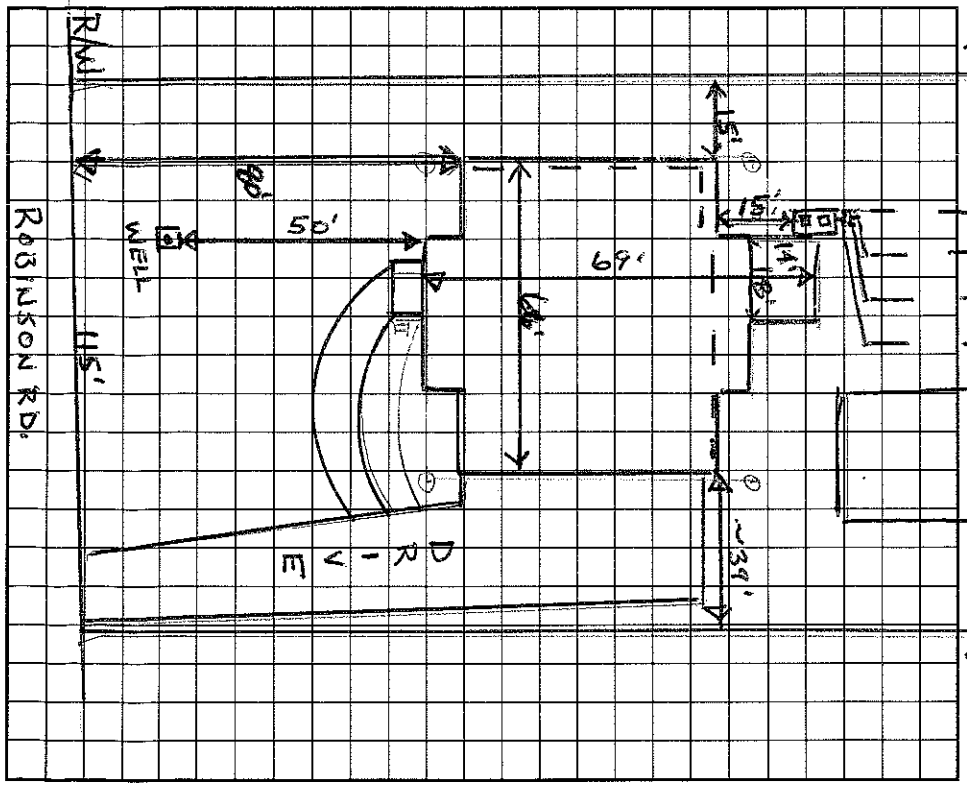

AS BUILT SKETCH

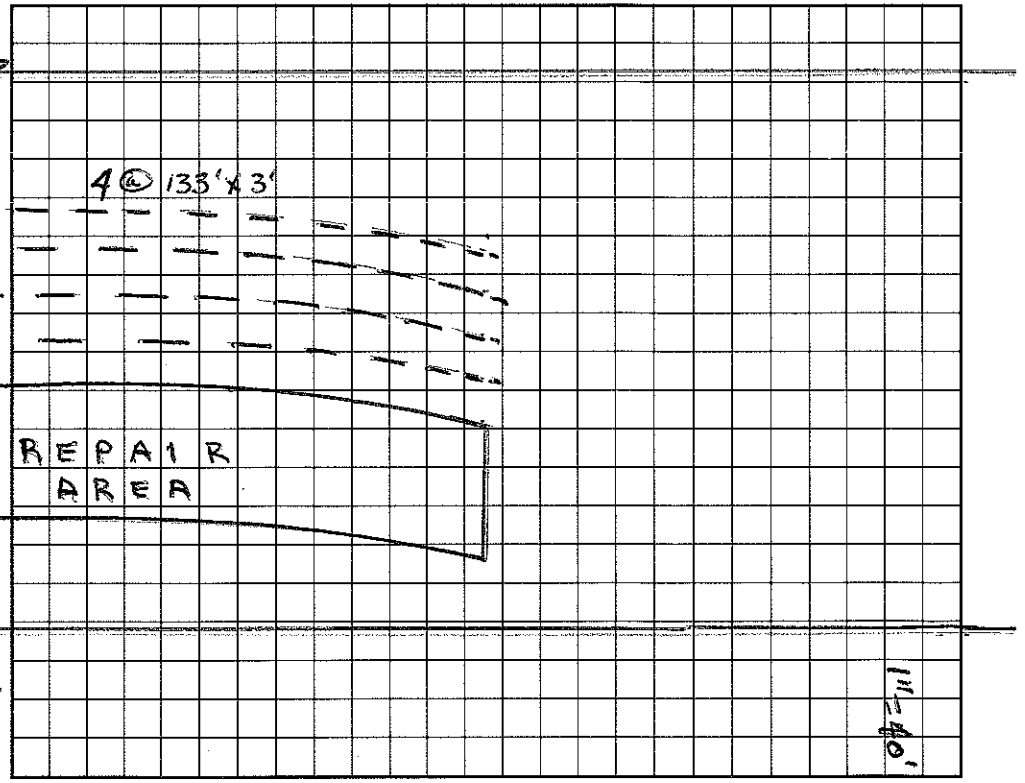

I understand that this permit can be suspended or revoked if any false information is supplied toward securing the permit/any unauthorized changes are made to the site/any unauthorized changes are made in the installation of the system. Improvement Permit is valid for 60 months from date of issuance.

Signed: * Phyllis Hoover

Improvement Permit by: Wesley Sparks RS. date 11/13/97

Authorization to Construct Existing System Inspection by: Wesley Sparks RS. date 11/13/97

Installed by: Chris Hedrick

Certificate of Completion by: Wesley Sparks RS date 4/3/98

Operation Permit by: Wesley Sparks RS. date 4/3/98

HEALTH DEPT. COPY: WHITE INSPECTION COPY (FINAL): GREEN OWNER COPY (FINAL): YELLOW INSPECTION COPY (INITIAL): PINK OWNER COPY (INITIAL): GOLD