IREDELL COUNTY HEALTH DEPARTMENT

STATESVILLE 704-878-5305 MOORESVILLE 704-664-5281

IMPROVEMENT PERMIT / AUTHORIZATION TO CONSTRUCT / OPERATION PERMIT / EXISTING SYSTEM INSPECTION

PERMIT# 075872 PIN# 4638140086 DATE Oct. 17, '98

OWNER OR CONTRACTOR Frank DeSimone PHONE: Business 788-6023 Home

ADDRESS 811 Rothmoor Dr. Concord, N.C. 28025

LOCATION 150 W TR Robinson Rd. ON Right

SUBDIVISION Robinson Woods BLOCK / SECTION LOT 12 LOT AREA .9 Ac SITE CLASS. PS DESIGN FLOW 480gpd L.T.A.R. .25

Septic Tank: 1000 Gallons; STB 97 Date 4/24/00

Pump Tank: Gallons; PT Date

Pump Make: Model Serial No.

Nitrification Field: No Fields 1 Square Feet 1425 Linear Feet 475

No Lines 5@95' Trench Width 36" Max Trench Bottom Depth 36"

☑ New System ☐ Repair System Type: I, II, ⓘ IV, V, VI

System Description: Gravity 25% Reduction

Repair System Description: LP 25-50% Reduction

Maintenance Agreement Required: ☐ Yes ☑ No

Gravel Depth NA

☑ House/Mod. Home No. Bedrooms 4

☐ Mobile Home No. Bathrooms 3

☐ Business No. Employees

☐ Other


☐ Slab ☑ Crawl Space ☐ Basement w/plumbing ☐ Basement wo/plumbing

Water Supply: ☑ Individual ☐ Public ☐ Community


Comments:/Conditions: * ONE INSPECTION PORT PER LATERAL. Remove any old trees & brush before installation of system. Install septic system during dry conditions.

Comments:/Conditions: 8/9/00 Driveway is not to pass over any part of drainfield.

1"=50' INITIAL SITE SKETCH

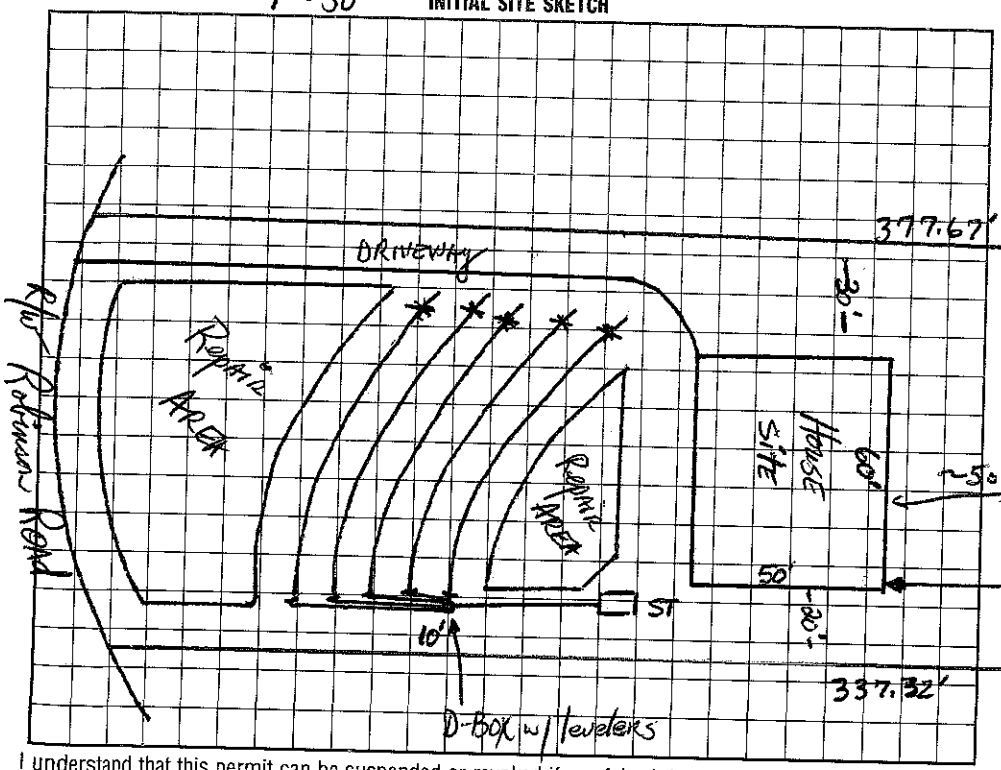

AS BUILT SKETCH

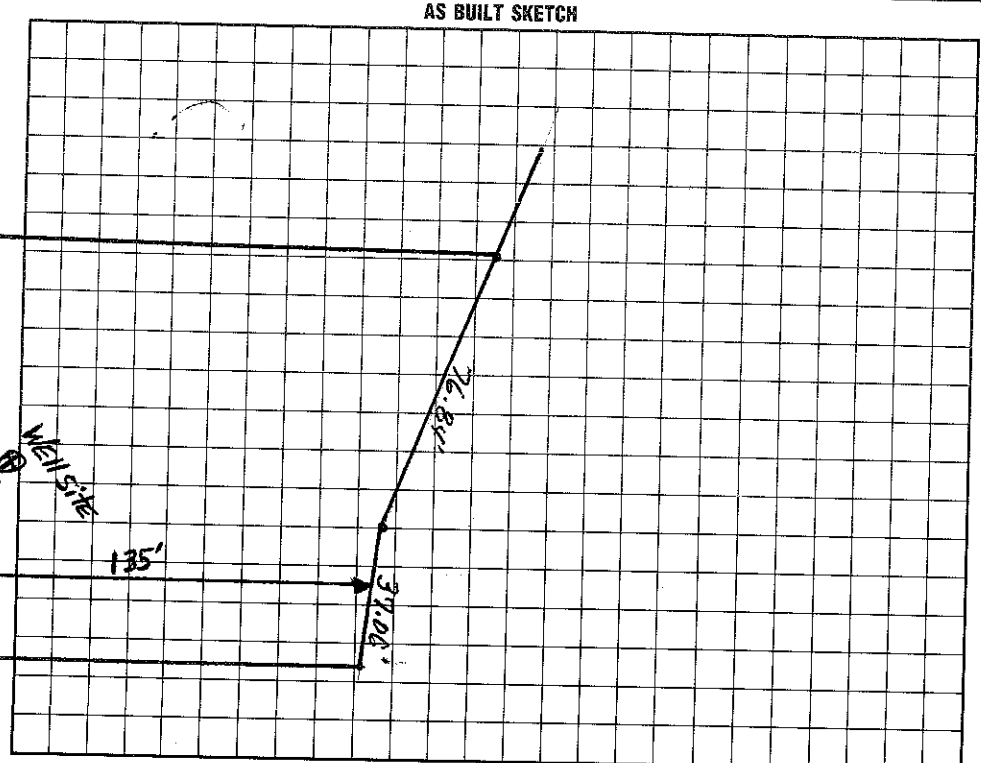

I understand that this permit can be suspended or revoked if any false information is supplied toward securing the permit/any unauthorized changes are made to the site/any unauthorized changes are made in the installation of the system. Improvement Permit with plat valid without expiration. Improvement Permit with site plan valid for sixty months. Authorization to Construct is valid for a period equal to that of Improvement Permit – not to exceed sixty months.

Signed: Thomas Beaver date 10-27-98

Improvement Permit by: Bruce R. Hinson, RS date 10-17-98

Authorization to Construct by: Bruce R. Hinson, RS date 10-17-98

Installed by: WT Norwood

Operation Permit by: Wesley Sparks RS date 8/9/00

Existing System Inspection by: date

HEALTH DEPT. COPY: WHITE INSPECTION COPY (FINAL): GREEN OWNER COPY (FINAL): YELLOW INSPECTION COPY (INITIAL): PINK OWNER COPY (INITIAL): GOLD