IREDELL COUNTY HEALTH DEPARTMENT

Statesville Phone TR 3-7271 Mooresville Phone NO 3-1271

PERMIT TO INSTALL SEPTIC TANK

Permit No. 47 Permit Date 4-20- 1972

Owner Rox Stallings Address Greensboro

Installed By Sam Oswalt Address Troutman


Location of Property 150 west to 1396 Go to pole A 22

Tank		Capacity		Length of Lines		Fixtures	
Block	( )	1000	(✓)	225'	(✓)	No. of Baths	(2)
Precast	(✓)	1250	( )	250'	( )	Dishwasher	(no)
		1500	( )	Other		Garbage Grdr.	(no)
		Other				Other	

NOTIFY HEALTH DEPARTMENT AT LEAST EIGHT HOURS BEFORE TANK IS TO BE INSPECTED.

Final Inspection 4-20- 1972 Approved (✓) Disapproved ( )

Remarks

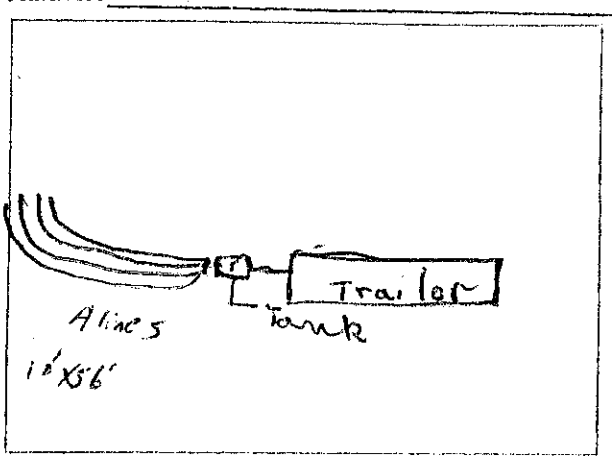

Sketch of Installation

A. C. Moore
Sanitarian