IREDELL COUNTY HEALTH DEPARTMENT

Statesville Phone TR 3-7271 Mooresville Phone NO 3-1271

PERMIT TO INSTALL SEPTIC TANK

Permit NO. _____ Permit Date 17 March 1970

Owner Stockton & Davis Address Winston Salem

Installed By Adams Septic Tank Address Taylorsville N C


Location of Property Lot # 80 Sec 1 Sect 15

Tank		Capacity		Length of Lines		Fixtures	
Block	( )	1000	( )	225'	( )	No. of Baths	(3)
Precast	(✓)	1250	(✓)	250'	( )	Dishwasher	( )
		1500	( )	Other 270		Garbage Grdr.	(✗)
		Other _____				Other _____	

NOTIFY HEALTH DEPARTMENT AT LEAST EIGHT HOURS BEFORE TANK IS TO BE INSPECTED.

Final Inspection 17 March 1970 Approved (✓) Disapproved ( )

Remarks _____

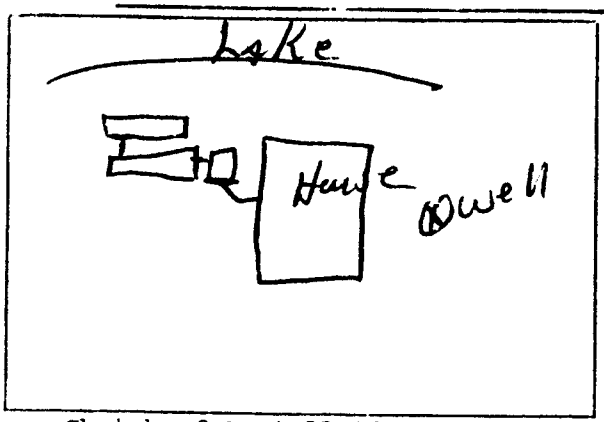

Sketch of Installation

Tony R. Sturgis

Sanitarian