3.30

IREDELL COUNTY HEALTH DEPARTMENT

STATESVILLE 704-878-5305 MOORESVILLE 704-664-5281

IMPROVEMENT PERMIT / AUTHORIZATION TO CONSTRUCT / OPERATION PERMIT / EXISTING SYSTEM INSPECTION

PERMIT# 149232 PIN# 4638162787 DATE 8-14-08

OWNER OR APPLICANT Mike Jacoy Custom Homes PHONE: Business 980-721-4763 Home

ADDRESS

LOCATION Perth Tl Fern Hill, Tl Broadview, on L

SUBDIVISION RLRT BLOCK / SECTION 15 LOT 79 LOT AREA .69 Ac SITE CLASS PS DESIGN FLOW 240 L.T.A.R. .35

Septic Tank: 1000 Gallons; STB 794 Date

Pump Tank: Gallons; PT Date

Pump Make: Model Serial No.

Nitrification Field: No Fields 1 Square Feet 720' Linear Feet 240'

No Lines 2@120' Trench Width 3' Max Trench Bottom Depth 3'

☒ New System ☐ Repair ☐ Expansion System Type: I II III IV V VI

System Description: Gravity 25% Red.

Repair System Description: LP-PPBPS

Maintenance Agreement Required: ☐ Yes ☒ No Initially

Gravel Depth — ☒ Gravity ☐ Pressure

☒ House/Mod. Home ☐ Mobile Home ☐ Business ☐ Other

No. Bedrooms 2 No. Persons No. Employees


☐ Slab ☐ Crawl Space ☒ Basement w/plumbing ☐ Basement wo/plumbing

Water Supply: ☒ Individual ☐ Public ☐ Community


Comments/Conditions: 1) If old bed system is hit while installing new lines, build an earth dam between the two to keep sewage from entering the old bed

Comments/Conditions: Installed Quick-4 Infiltrator

INITIAL SITE SKETCH

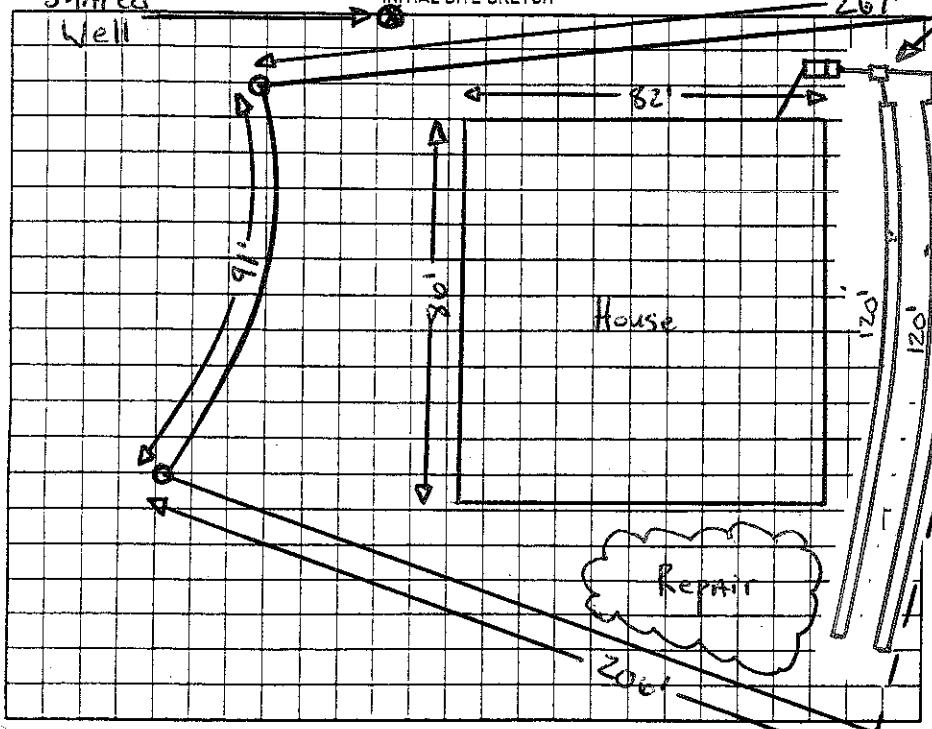

AS BUILT SKETCH

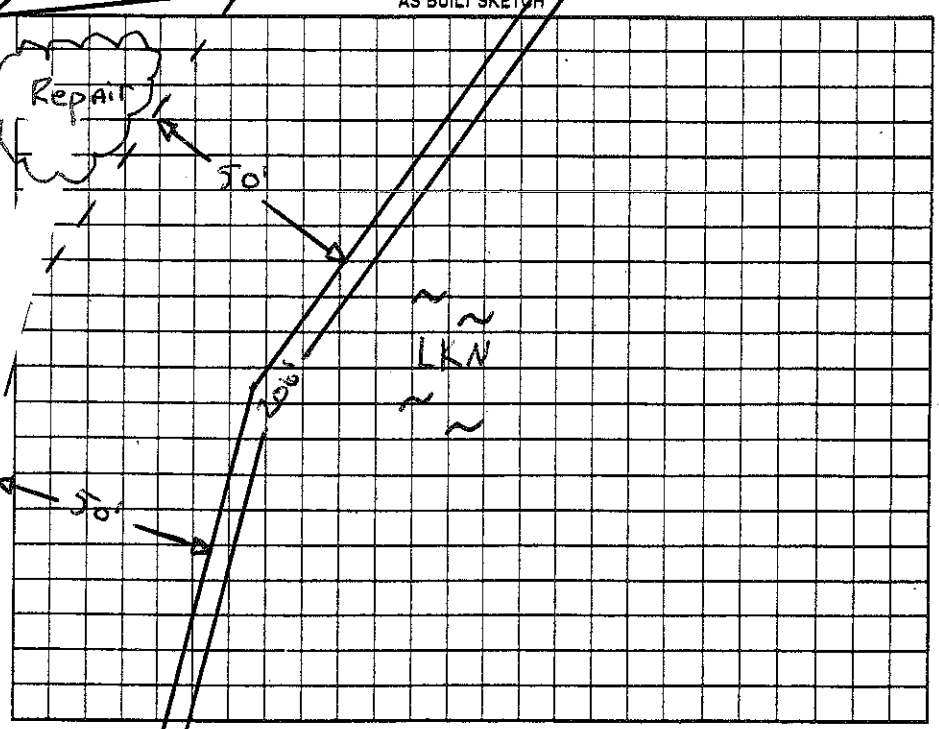

Permit can be suspended or revoked if any false information is supplied toward securing the permit/any unauthorized changes are made to the site/any unauthorized changes are made in the installation of the system. Improvement Permit with plat valid without expiration ☐ Improvement Permit with site plan valid for sixty months ☒ Authorization to Construct is valid for a period equal to that of Improvement Permit – not to exceed sixty months.

Signed: date Installed by: Richard Abernathy

Improvement Permit by: B-A date 8-14-08 Operation Permit by: B-A date 8-15-08

Authorization to Construct by: B-A date 8-14-08 Existing System Inspection by: date

HEALTH DEPT. COPY: WHITE OWNER COPY (FINAL): YELLOW OWNER COPY (INITIAL): PINK