IREDELL COUNTY HEALTH DEPARTMENT

STATESVILLE 704-878-5305 MOORESVILLE 704-664-5281

IMPROVEMENT PERMIT / AUTHORIZATION TO CONSTRUCT / OPERATION PERMIT / EXISTING SYSTEM INSPECTION

PERMIT# 072276 PIN# 4638 17 2655 2666 DATE 4/1/98

OWNER OR CONTRACTOR Doug + Karen Lewis PHONE: Business Home 528-6512

ADDRESS 119 Broadview Loop Mooresville, NC 28115

LOCATION Fern Hill Tr 1st Broadview Loop to 2ND lot on (L)

SUBDIVISION @ CLT BLOCK / SECTION 15 LOT 1011 LOT AREA 1.23AC SITE CLASS. PS DESIGN FLOW 360 L.T.A.R. .3

Septic Tank: 1000 Gallons; STB 1017 Date 9/18/98
Pump Tank: Gallons; PT Date
Pump Make: Model Serial No.
Nitrification Field: No Fields 1 Square Feet 900 Linear Feet 300*
No Lines 4 Trench Width 36" Max Trench Bottom Depth 36" Gravel Depth SAND

[X] New System [ ] Repair System Type: I, II, III, IV, V, VI
System Description: GRAV - Type 3
Repair System Description: Pressure
Maintenance Agreement Required: [ ] Yes [X] No


[X] House/Mod. Home [ ] Mobile Home [ ] Business [ ] Other
No. Bedrooms 3 No. Bathrooms 2.5 No. Employees
[ ] Slab [ ] Crawl Space [X] Basement w/plumbing [ ] Basement wo/plumbing

Water Supply: [X] Individual [ ] Public [ ] Community


Comments:/Conditions: * 25% reduction for use of Type 3 Drainfield material

Comments:/Conditions:

INITIAL SITE SKETCH

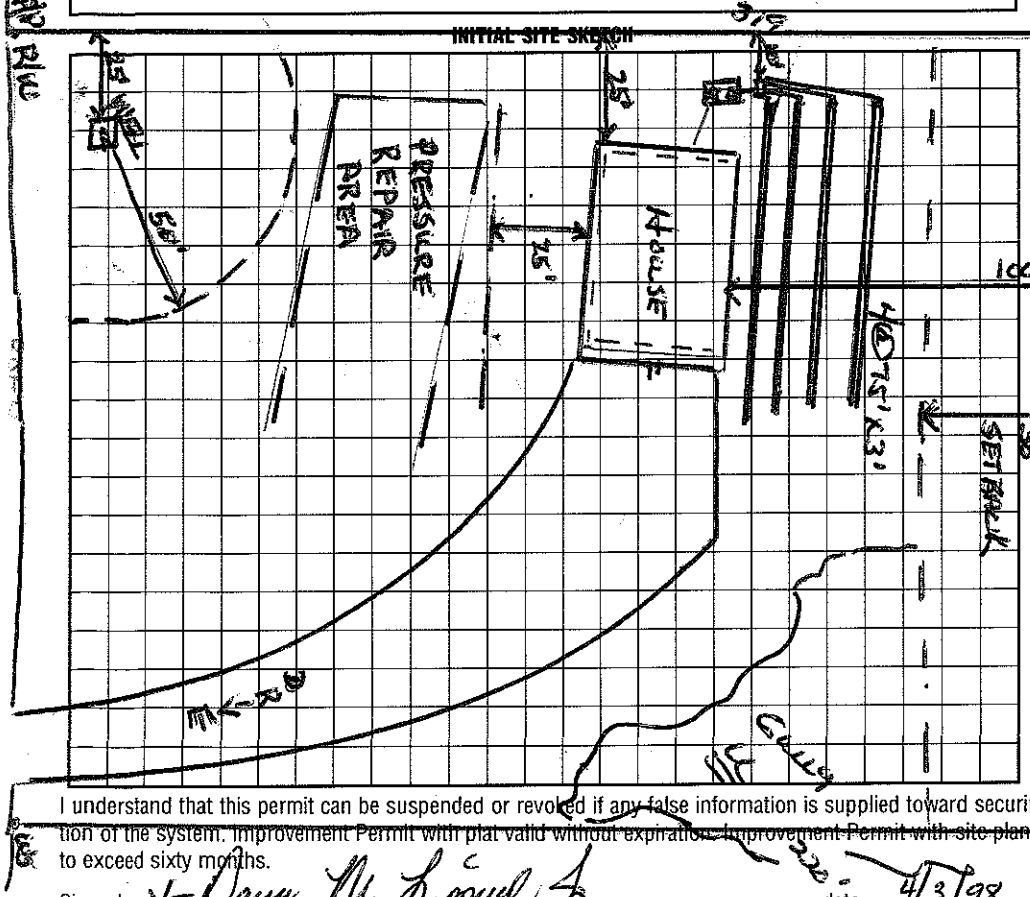

AS BUILT SKETCH

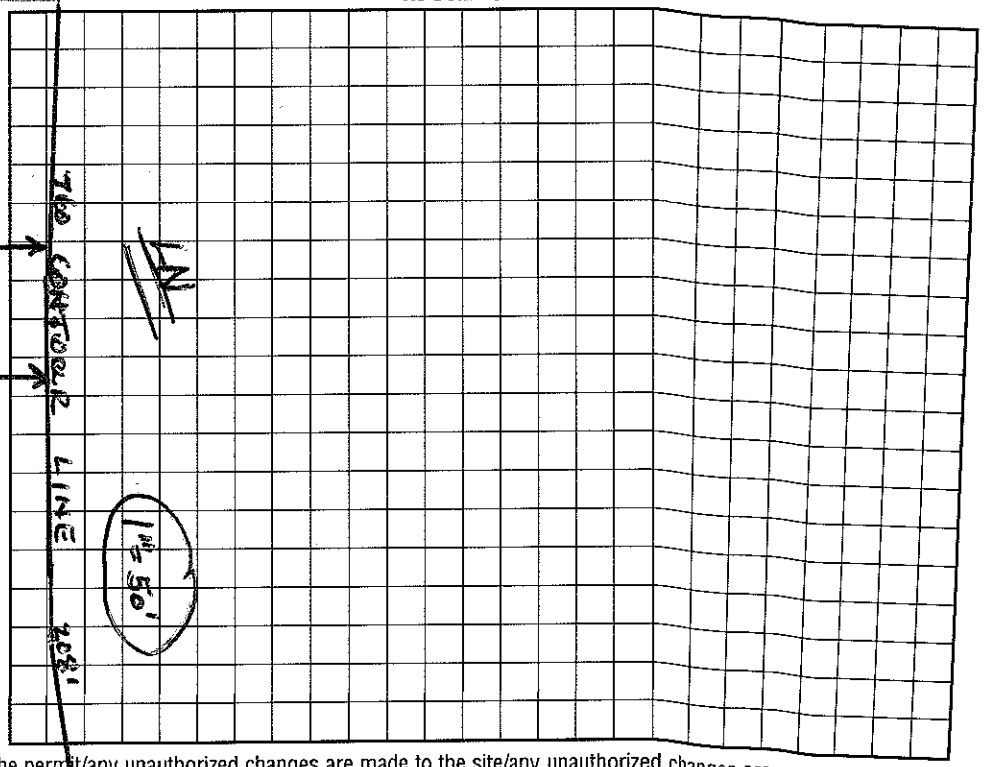

I understand that this permit can be suspended or revoked if any false information is supplied toward securing the permit/any unauthorized changes are made to the site/any unauthorized changes are made in the installation of the system. Improvement Permit with plat valid without expiration. Improvement Permit with site plan valid for sixty months. Authorization to Construct is valid for a period equal to that of Improvement Permit – not to exceed sixty months.

Signed: * Doug McLewis date 4/3/98 Installed by: David Gourley

Improvement Permit by: Wesley Sparks R.S. date 4/1/98 Operation Permit by: Wesley Sparks R.S. date 11/3/98

Authorization to Construct by: Wesley Sparks R.S. date 4/1/98 Existing System Inspection by: date

HEALTH DEPT. COPY: WHITE INSPECTION COPY (FINAL): GREEN OWNER COPY (FINAL): YELLOW INSPECTION COPY (INITIAL): PINK OWNER COPY (INITIAL): GOLD