IREDELL COUNTY HEALTH DEPARTMENT

Statesville Phone TR 3-7271 Mooresville Phone NO 3-1271

PERMIT TO INSTALL SEPTIC TANK

Permit No. 81 Permit Date 5-17 1972

Owner Lamar Sprinkle Address Winston Salem NC

Installed By Kannapolis Ser. Co Address Kannapolis NC


Location of Property Below Fern Hill Church Lot # 75 Section # 15 On Broadview Circle on left.

Tank		Capacity		Length of Lines		Fixtures	
Block	( )	1000	(✓)	225'	(✓)	No. of Baths	(1)
Precast	(✓)	1250	( )	250'	( )	Dishwasher	( )
		1500	( )	Other		Garbage Grdr.	( )
		Other				Other	

NOTIFY HEALTH DEPARTMENT AT LEAST EIGHT HOURS BEFORE TANK IS TO BE INSPECTED.

Final Inspection 5-17 1972 Approved (✓) Disapproved ( )

Remarks Well not down yet. Later

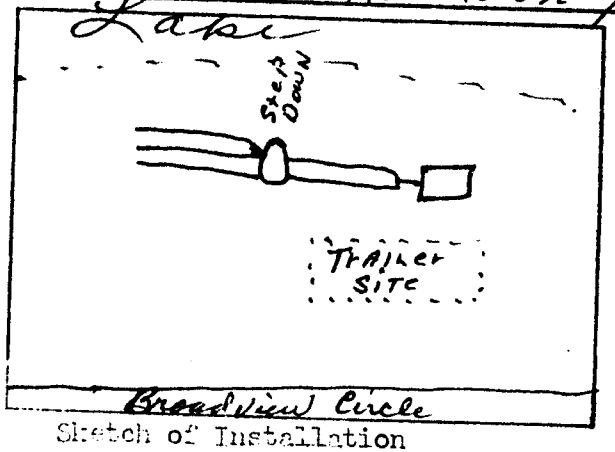

Sketch of Installation

E. A. Stevenson

Sanitarian