IREDELL COUNTY HEALTH DEPARTMENT

STATESVILL... 704-878-5305 MOORESVILLE 704-664-5281

IMPROVEMENT PERMIT / AUTHORIZATION TO CONSTRUCT / OPERATION PERMIT / EXISTING SYSTEM INSPECTION

PERMIT# 140319 PIN# 4638 17 4021 DATE 4/23/07

OWNER OR APPLICANT Nanty Bentley Co THAI PHAN PHONE: Business 704-528-6043 Home

ADDRESS 147 Nanty Wood Lane Troutman, NC 28166

LOCATION 149 Broadview Circle, Perth, N TL Fern Hill, TL 1ST Broadview Cir, on L # 149

SUBDIVISION CL+T BLOCK / SECTION 15 LOT 77 LOT AREA .88 SITE CLASS PS DESIGN FLOW 360 L.T.A.R. .3

Septic Tank: 1000 Gallons; STB 1012 Date 2/26/08
Pump Tank: Gallons; PT Date
Pump Make: Model Serial No.
Nitrification Field: No Fields 1 Square Feet 600 Linear Feet 200
No Lines 4@50' Trench Width 3' Max Trench Bottom Depth 3' Gravel Depth NA

☒ New System ☐ Repair ☐ Expansion System Type: I II (III) IV V VI
System Description: GRAVITY - PPBPS
Repair System Description: < 83 LOT
Maintenance Agreement Required: ☐ Yes ☐ No
☒ Gravity ☐ Pressure

☒ House/Mod. Home No. Bedrooms 3
☐ Mobile Home No. Persons
☐ Business No. Employees
☐ Other


Water Supply: ☒ Individual ☐ Public ☐ Community

☐ Slab ☐ Crawl Space ☐ Basement w/plumbing ☐ Basement wo/plumbing

Comments:/Conditions:


200
130'

INITIAL SITE SKETCH

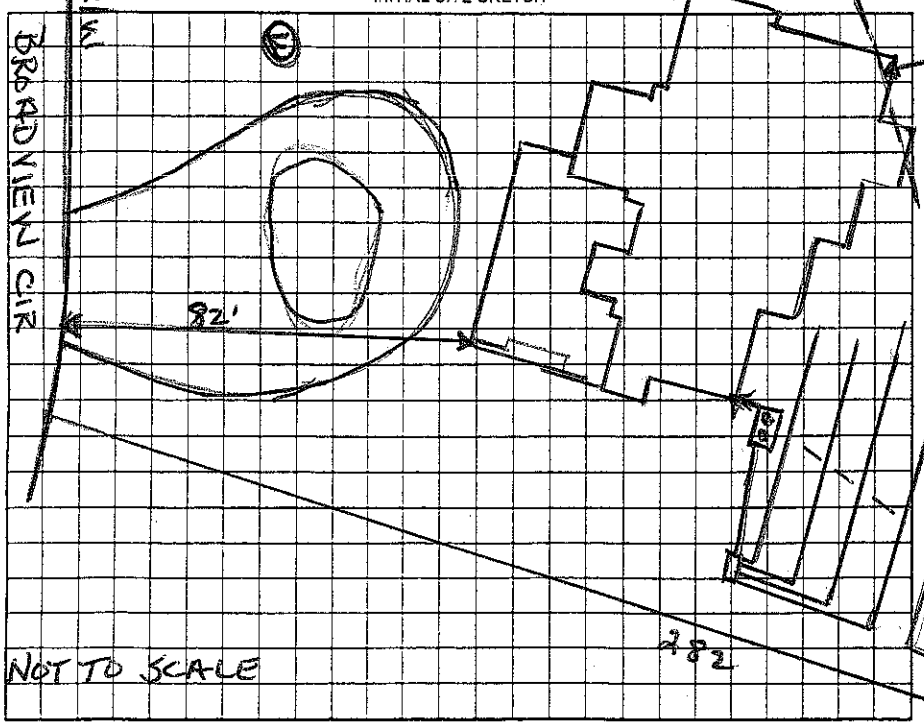

Comments:/Conditions:

AS BUILT SKETCH

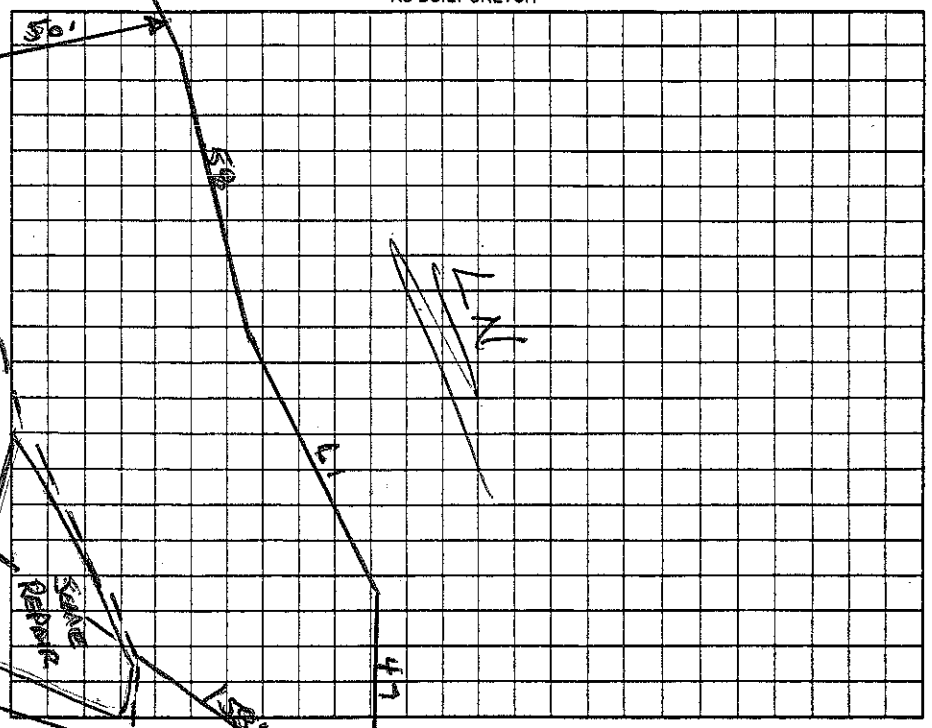

Permit can be suspended or revoked if any false information is supplied toward securing the permit/any unauthorized changes are made to the site/any unauthorized changes are made in the installation of the system. Improvement Permit with plat valid without expiration. ☐ Improvement Permit with site plan valid for sixty months ☐ Authorization to Construct is valid for a period equal to that of Improvement Permit – not to exceed sixty months.

Signed: [signature] date

Improvement Permit by: Wesley Sparks RS. date 4/23/07

Authorization to Construct by: Wesley Sparks RS. date 4/23/07

Installed by: [signature]

Operation Permit by: Wesley Sparks RS. date 12/30/08

Existing System Inspection by: date

HEALTH DEPT. COPY: WHITE OWNER COPY (FINAL): YELLOW OWNER COPY (INITIAL): PINK