IREDELL COUNTY HEALTH DEPARTMENT

STATESVILLE 704-878-5305 MOORESVILLE 704-664-5281

IMPROVEMENT PERMIT / AUTHORIZATION TO CONSTRUCT / OPERATION PERMIT / EXISTING SYSTEM INSPECTION

PERMIT# 122355 PIN# 4638-18-1089 DATE 7/22/04

OWNER OR CONTRACTOR Nantz Building Co. PHONE: Business 704 528 6043 Home

ADDRESS 147 Nantz Woods Ln Troutman NC 28166

LOCATION Perth & TL Fern Hill, Just past 2nd Kenway Up

SUBDIVISION CLH BLOCK / SECTION 15 LOT 103 LOT AREA SITE CLASS. PS DESIGN FLOW 360 L.T.A.R. 0.25

* Septic Tank: 1000 ~~Existing~~ Gallons; STB 1012 Date 8/4/05

Pump Tank: Gallons; PT Date

Pump Make: Model Serial No.

Nitrification Field: No Fields 1 Square Feet 1080 Linear Feet 360

No Lines 4@90° Trench Width 36" Max Trench Bottom Depth 24" Gravel Depth —

☒ New System ☐ Repair System Type: I, II, (III) IV, V, VI

System Description: Gravity 25% Reduct

Repair System Description: Pump Innovative

Maintenance Agreement Required: ☐ Yes ☒ No

☒ House/Mod. Home No. Bedrooms 3

☐ Mobile Home No. Bathrooms

☐ Business No. Employees

☐ Other


☐ Slab ☒ Crawl Space ☐ Basement w/plumbing ☐ Basement wo/plumbing

Water Supply: ☒ Individual ☐ Public ☐ Community Existing

Comments:/Conditions: *


Comments:/Conditions:

INITIAL SITE SKETCH

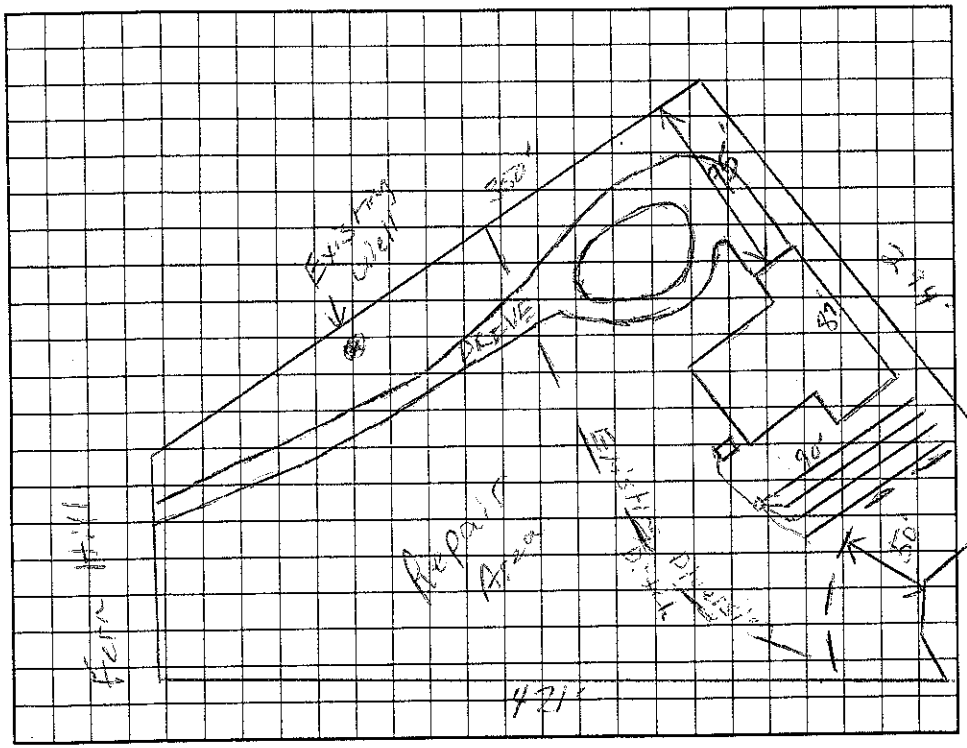

AS BUILT SKETCH

Infiltrator Quick 4

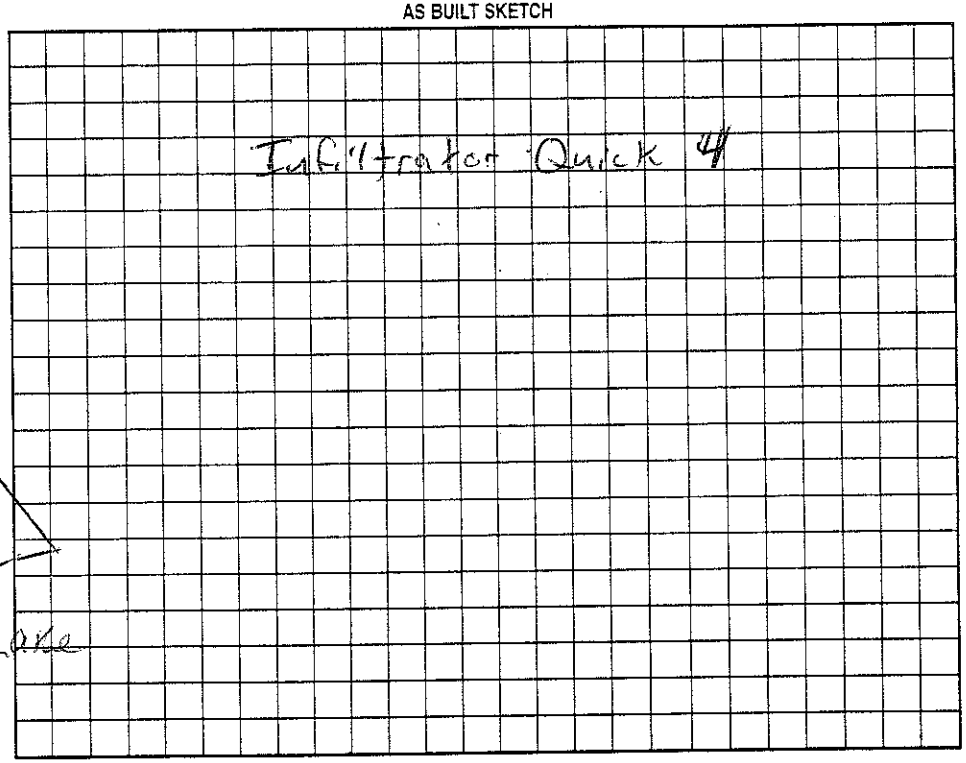

Permit can be suspended or revoked if any false information is supplied toward securing the permit/any unauthorized changes are made to the site/any unauthorized changes are made in the installation of the system. Improvement Permit with plat valid without expiration. Improvement Permit with site plan valid for sixty months. Authorization to Construct is valid for a period equal to that of Improvement Permit – not to exceed sixty months.

Signed: date 7/26/04 Installed by: Tommy Frye

Improvement Permit by: RS date 7/22/04 Operation Permit by: RS date

Authorization to Construct by: RS date 7/22/04 Existing System Inspection by: date

HEALTH DEPT. COPY: WHITE OWNER COPY (FINAL): YELLOW OWNER COPY (INITIAL): PINK