Pd 365.00 MW

# IREDELL COUNTY HEALTH DEPARTMENT

STATESVILLE 704-878-5305 MOORESVILLE 704-664-5281

## IMPROVEMENT PERMIT / AUTHORIZATION TO CONSTRUCT / OPERATION PERMIT / EXISTING SYSTEM INSPECTION

PERMIT # 162619 PIN # 4638184307 DATE 9-10-2010

OWNER or APPLICANT Don King PHONE: Business 704 561-3114 Home: 704 528-6926

OWNER or APPLICANT ADDRESS P.O. Box 3271 Mooresville, NC 28117 704 996-6119

LOCATION / DIRECTIONS Hwy 150 TR Perth Rd TL Kenway Loop (2nd) 1st House on right

SUBDIVISION Kenway Place BLOCK / SECTION LOT # 5 LOT AREA 1.29Ac DESIGN FLOW 480 L.T.A.R. .3

Septic Tank A 1000 Gallons: STB 312 Date 6-15-10

Pump Tank A 1000 Gallons: PT 283 Date 7-31-10

Pump Make Gouldes Model Serial #

Nitrification Field No Fields 1 No Lines 3 Linear Feet 270'

Trench Width 36" Max. Trench Bottom Depth 32" Gravel Depth N/A

☐ New System ☐ Repair ☐ Expansion System Type I II III IV V VI

System Description: Pump-4-Panel Block

Repair System Description: Same

Maintenance Agreement Required ☒ YES ☐ NO

☐ GRAVITY ☒ PRESSURE

☒ Residence No. Bedrooms 4

☐ Business No. Persons

☐ Other No. Employees

☐ Slab ☐ Crawl Space


☐ Basement w/plumbing ☐ Basement w/o plumbing

Water Supply: ☒ Private ☐ Public ☐ Community


Comments / Conditions: Abandoned existing ST & PT and installed new ones) Must be At least 5ft from any building & 10ft From PL

Comments / Conditions: Okay to Build outdoor Kitchen as shown. Do not build on top of Supply line)

INITIAL SITE SKETCH

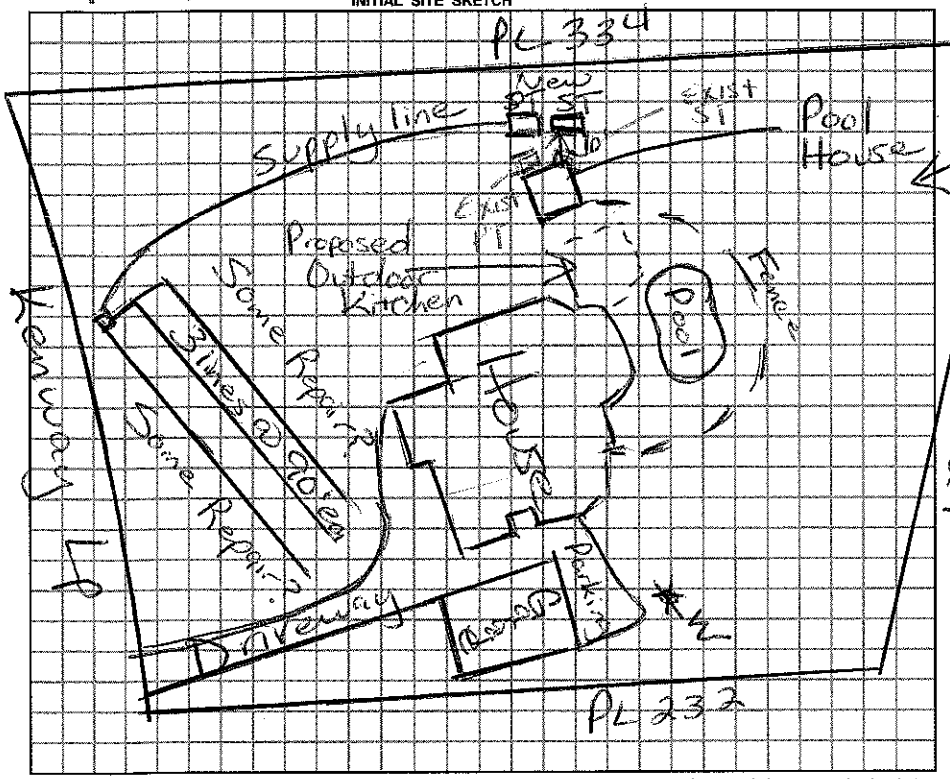


AS BUILT SKETCH

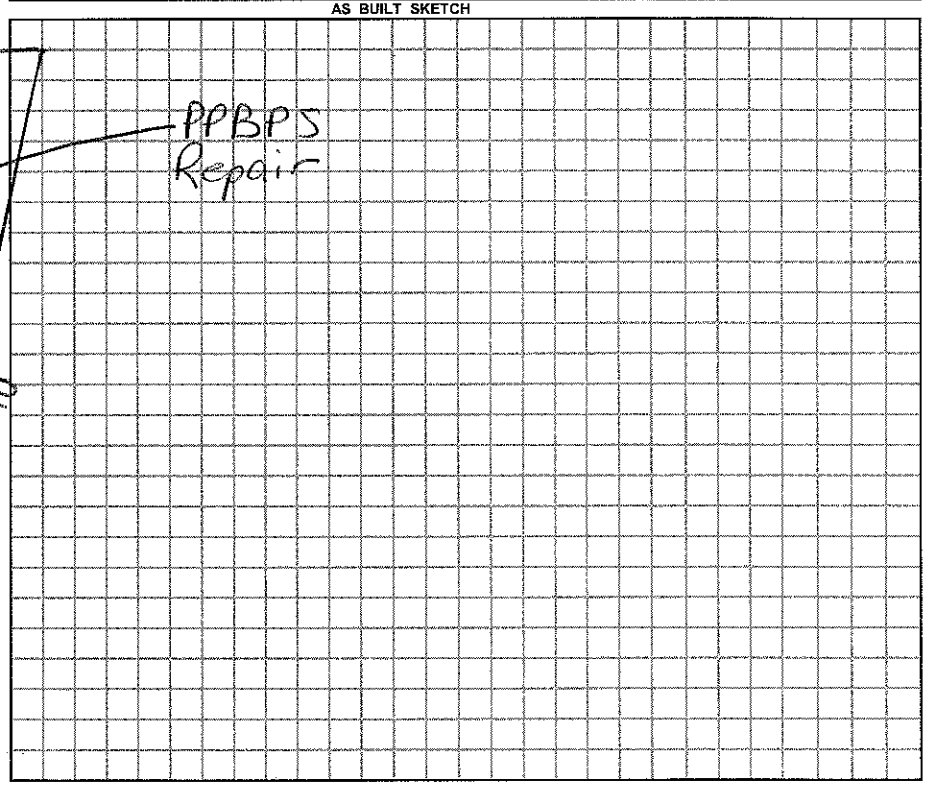


*Permit can be suspended or revoked if any false information is supplied toward securing the permit / any unauthorized changes are made to the site / any unauthorized changes are made in the installation of the system.*

☐ *IMPROVEMENT PERMIT w / plat valid without expiration.* ☐ *IMPROVEMENT PERMIT w / site plan valid for 60 mos.* ☐ *AUTHORIZATION TO CONSTRUCT valid for period equal to IMPROVEMENT PERMIT-not to exceed 60 mo.*

Owner / Applicant Signature: Don King Date 9/10/10

Improvement Permit by: Melissa H. Dotson RS Date 9/10/2010

Authorization to Construct by: Melissa H. Dotson RS Date 9/10/2010

***YOU SHOULD CONTACT A LOCATOR SERVICE PRIOR TO ANY EXCAVATION.***

Installed by: Larry Beam Grading

Operation Permit by: Melissa H. Dotson RS Date: 9/15/10

Existing System Inspected by: Date:

WHITE COPY Environmental Health YELLOW COPY (Final) Owner / Applicant PINK COPY (Initial) Owner / Applicant